

CENTRAL MAPPING AUTHORITY
Department of Lands

Trigonometrical Survey of N.S.W.

RECONNAISSANCE and MAINTENANCE REPORT

This Trig. Station has been:

Note: Cross out word or words which do not apply

1. Completely cleared to permit 360° vision to surrounding Trigs.
2. Cleared by lanes bearing..... from Trig. Mast
3. Trig. Mast & Vanes have been painted white & black respectively.
4. The Trig. was unpiled/~~not unpiled~~, dimensions now being: Original Station Mark found / ~~not found~~

Description of mark..... Bottle in concrete..... should be explicit, e.g. Steel plug, Brass plug, Bolt, G.I. Pipe
 Height of mark..... 0.00..... m above..... 0.00..... m below..... G.L.
 Height of Top Vanes to Top Mark..... 3.716..... m. Diameter of Vanes (vertical)..... 0.920..... m.
 Height of Cairn..... 1.1..... m. Diameter of Cairn..... 1.6..... m.
 Length of Mast..... 5.716..... m. (approximate if not unpiled)


5. A. G.I. Pipe..... set in conc./~~soil~~ has been placed..... 4.041..... m. bearing..... 245°..... °M from Trig. (*Bottle in conc.*)
6. A. Cu. Nail..... set in conc./~~soil~~ has been placed..... 2.142..... m. bearing..... 140°..... °M from Trig. (*Bottle in conc.*)
7. A..... set in conc./soil has been placed..... m. bearing..... °M from Trig.
8. A..... set in conc./rock has been placed..... m. bearing..... °M from Trig. Mast
9. Connection..... G.I. Pipe..... to..... Cu. Nail..... :..... 4.984..... m. bearing..... 89°..... °M
10. Connection..... to..... m. bearing..... °M
11. Connection..... to..... m. bearing..... °M
12. Connection..... to..... m. bearing..... °M
13. Diff. Ht. G.I. Pipe..... is..... 0.192..... m. above..... bottle in conc. below
14. Diff. Ht. Cu. Nail..... is..... 0.079..... m. above..... bottle in conc. below
15. Diff. Ht. Cu. Nail..... is..... 0.115..... m. above..... G.I. Pipe below
16. Diff. Ht. is..... m. above..... below

Prepared by: D. Kingside Checked: 14/12/16 Noted on U.T.M. Card

STATION ISOLATION T-5 2568

Cor: GOLUCH | Ph: GORDON
 Map Sheet: Clear Traces N | No: 9283
 Inspected by: D. Kingside | Date: 9-3-75 2-11-75
 Authority: CMAA 72/66 | Field Book: 181239, 1471

Beacon Diagram Not to Scale

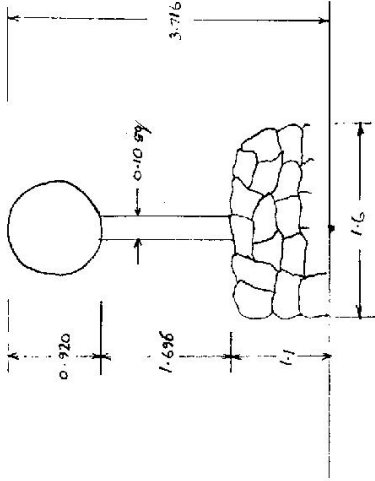

Date Record of Station

STATION ISOLATION T S 2568

Owners Name.....
 Current Occupant.....

Address.....
 Address.....

Owners Name.....
 Address.....


Address.....
 Address.....

Access 1-8-1976 ; 2-11-1975

Access 2-12-1975

Not to Scale

Station Diagram

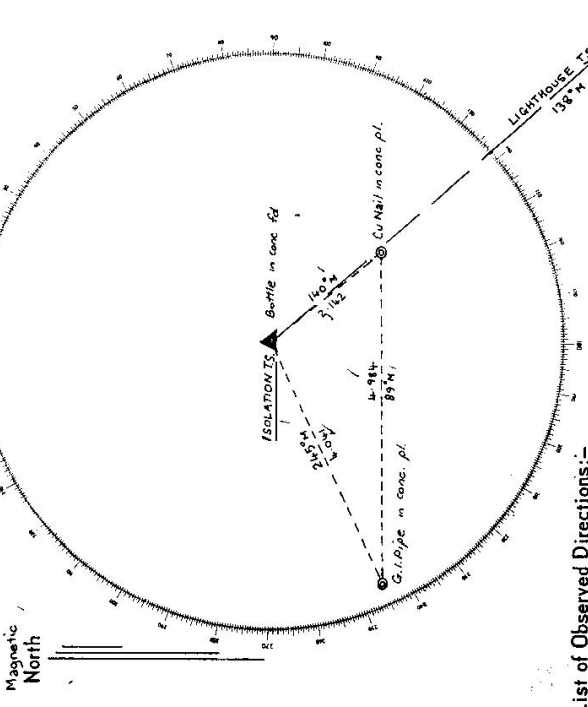

List of Observed Directions:-

Station	Direction	Station	Direction
Cu Nail in conc. placed	340° 00'	Bottle in conc. fd	360° 00'
G.I. Pipe in conc. placed	103° 13'	Cu Nail in conc. placed	24° 42'
* Standpoint: Cu Nail in conc. placed (9-8-75) Standpoint: Cu Nail in conc. fd (2-11-75)			
Bottle in conc. fd	52° 05'	LIGHTHOUSE T.S.	359° 59' 60"
G.I. Pipe in conc. pl.	360° 00'	G.I. Pipe in conc. fd	127° 27'
		Centre of Mast	179° 54'
* No Fog for P.O. visible			

ACCESS TO ISOLATION T.S.

