

STATION **TS 2575 NORTHBRIDGE (38)**
 Co: **CUMBERLAND** Ph: **WILLOUGHBY**
 Map Sheet: **1:10 000 MOSMAN** No: **1852 - I**
 Inspected by: **E. GAUGAIN** Date: **17-10-79**
 Authority: **I. S. B.** Field Book: **1418-3**

Beacon Diagram Not to Scale

STEEL PLUG IN ROCK.

**ORIGINALLY RECORDED AS
 J 8 IN 1855 REGISTER.**

Date	Record of Station

Department of Lands Integral Survey of N.S.W.
RECONNAISSANCE AND MAINTENANCE REPORT

This Trig. Station has been: Note: Cross out word or words which do not apply

1. ~~Completely cleared to permit 360° vision to surrounding trigs.~~
2. ~~Cleared by James bearing~~ from Trig. Mast
3. ~~Trig. Mast & Vanes have been painted white & black respectively~~
4. ~~The Trig. was unpiled/not unpiled, dimensions now being:~~

Description of mark: **STEEL PLUG** should be explicit, e.g. Steel plug, Brass plug, Bolt, Concrete Pillar
 Height of mark: **0.00** m ^{above} rock, **concrete** m ^{below} G.L.
 Height of Top Vanes to Top Mark/Top pillar plate: _____ m Diameter of Vanes (vertical) _____ m.
 Height of Cairn: _____ m. Diameter of Cairn: _____ m.

- Length of Mast: _____ m. (approximate if not unpiled)
5. A. _____ set in conc./rock has been placed/fd _____ m. bearing _____ °M from Trig. Mast/pillar
 6. A. _____ set in conc./soil has been placed/fd _____ m. bearing _____ °M from Trig. Mast/pillar
 7. A. _____ set in conc./soil has been placed/fd _____ m. bearing _____ °M from Trig. Mast/pillar
 8. A. _____ set in conc./rock has been placed/fd _____ m. bearing _____ °M from Trig. Mast/pillar

9. Connection: _____ to _____ m. bearing _____ °M
10. Connection: _____ to _____ m. bearing _____ °M
11. Connection: _____ to _____ m. bearing _____ °M
12. Connection: _____ to _____ m. bearing _____ °M
13. Diff. Ht. _____ is _____ m. ^{above} _{below}
14. Diff. Ht. _____ is _____ m. ^{above} _{below}
15. Diff. Ht. _____ is _____ m. ^{above} _{below}
16. Diff. Ht. _____ is _____ m. ^{above} _{below}


Prepared by: E. GAUGAIN Checked: _____

STATION **TS 2575 NORTHBRIDGE (JB)**

Owners Name: **PUBLIC RESERVE** Current Occupant:

Address: Address:

Access **17-10-1919 FOLLOW PATH TO HIGHEST POINT IN RESERVE**

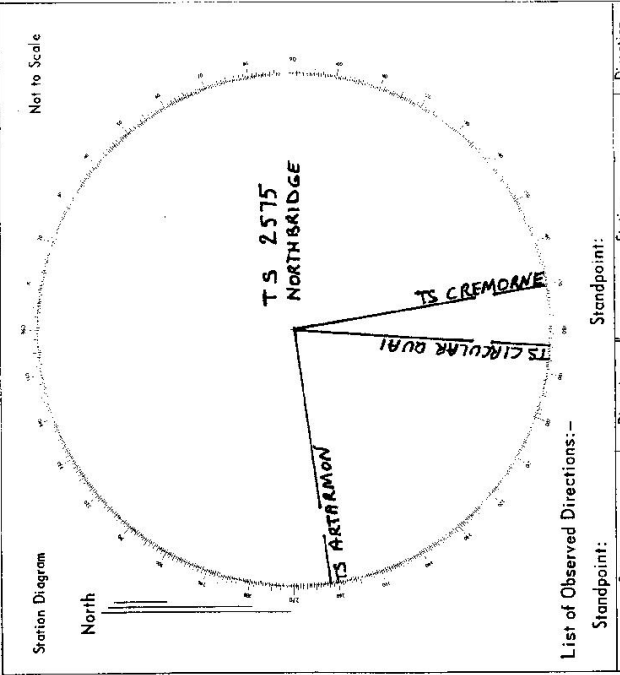

List of Observed Directions:-

Standpoint:		Station:	
Station	Direction	Station	Direction
TS CREMDANE	170° 00' 00"		
TS CIRCULAR QUIA	183° 16' 53"		
TS AXTARMON	261° 54' 20"		
Station	Direction	Station	Direction

