

GEODETTIC SURVEY OF M.S.W.

CENTRAL MAPPING AUTHORITY

GEODETTIC STATION RECONNAISSANCE and MAINTENANCE REPORT

Description:

1. Cleared by lanes bearing 304° , 30° , 119° \rightarrow 129° from Trig, Mast
Note: Cross out word or words which do not apply
2. Mast & Vanes have been painted white & black respectively.
3. The station ~~has been~~ ~~was~~ ~~is~~ ~~not~~ ~~unfilled~~ ~~reconstructed~~ on $31.1.19$, dimensions now being:
 Description of mark.....should be explicit, e.g., S/Steel Pillar Plate, Steel plug, Brass plug, Bolt, G.I. Pipe
 Height of mark.....m. above rock/concrete; Mark ism. above G.L.
 Height of Top Vanes to Top Mark/Pillar platem. Diameter of Vanes (vertical) 0.890 m.
 Height of Cairn.....m. Diameter of Cairn.....m. Name Plate ~~found~~ not found ~~placed~~.
 Length of Mast.....m. (approximate if not unpiled)
4. A..... $31.1.19$ set in ~~concrete~~ ~~rock~~ ~~found~~, bearing 126° M from Mast ~~Plug/Pillar~~ / 94°
Set!
5. A..... set in conc/rock has been placed/found, bearing..... M from Mast/Plug/Pillar
6. A..... set in conc/rock has been placed/found, bearing..... M from Mast/Plug/Pillar
7. A..... set in conc/rock has been placed/found, bearing..... M from Mast/Plug/Pillar
8. Action required: ~~Mast~~ ~~van~~ ~~is~~ ~~not~~ ~~planted~~ ~~in~~ ~~conc~~ ~~if~~ ~~feasible~~
 1 day clearing for 2 necessary lines

STANDPOINT:

Trigs	Mark Sighted	Grid Direction	Horiz. Distance	Height Difference	Grid Direction	Horiz. Distance	Height Difference
	Hills	Mark Sighted					
	Capmohurst	51	22.2	above standpt.			
	Blackland	143	30.6	above standpt.			
	Bunball	254	3.5	above standpt.			
	Walker	242	10.4	above standpt.			
				above standpt.			
				above standpt.			
				above standpt.			
				above standpt.			

Prepared by: *J. Fanning* Checked: *W. J. 29/7/25* Noted on U.T.M. Card

ST 2738 - 1

STATION: **TACKADGERY G.I.** No.: **2576**

MAP SHEET SCALE 1:250 000 **GRAFTON**

INSPECTED BY: **J. FANNING** DATE: **31.1.19**

AUTHORITY: **C.M.A.** FIELD BOOK: **1765**

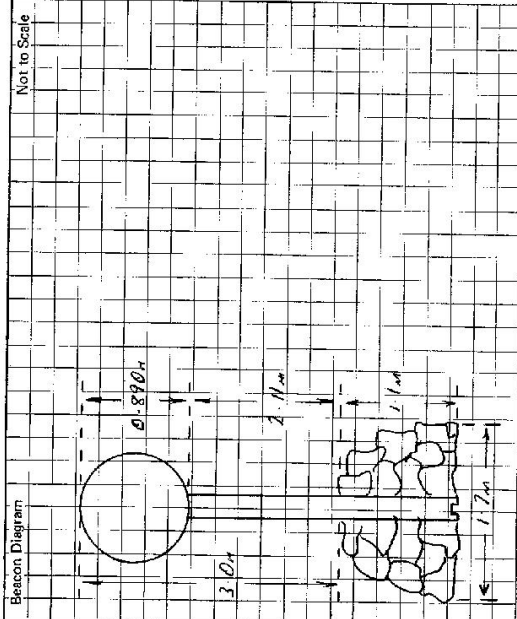
Station Diagram

North

Not to Scale

Checked

Sr 2739 - 2 D. West, Government Printer

<p>STATION JACKADGERY IS 2576</p> <p>Owner's Name: <u>Jeanette Hayes</u> Address: <u>Bundahl Property</u> <u>Remorse via Grafton</u> Phone: <u>424654</u></p> <p>Current Occupant: <u>Owner consent to</u> Address: <u>any clearing necessary only</u> <u>Contact owner before clearing</u> Phone: <u>Trig</u></p> <p>ACCESS <u>31st July 1979</u></p> <p>Access Report of 25/11/1979 was found suitable/unsuitable.</p> <p><u>ACCESS</u></p> <p>0.00 Sth Grafton P.O. travel west on Baydri Highway 240.00 Turn left 'Bundahl' Property road before Logabary Creek 0.22 Pass house - shed LHS 0.77 ahead gate 0.97 Track joins from LHS 3.13 Take right fork 3.58 Iron gate 3.88 Pass around dam RHS 5.01 Iron gate 5.05 take right fork 5.95 Iron gate cont last attached 5.99 take right fork 10.48 take left fork up hill 11.45 stop vehicle at blazed tree. walk up hill to right between tick fences 3 Minutes walk to Trig</p>	<p>Not to Scale</p>  <p>This section to be completed by officer constructing pillar.</p> <p>Original station mark found/not found.</p> <p>Description of mark:</p> <p>Original beacon found/not found.</p> <p>Description of beacon:</p> <p>Height Top of Vanes to Top Markm.</p> <p>Height of markm. above G.L. below</p> <p>Diameter of Vanesm. Height of Cairnm.</p> <p>Original Beacon has/has not been destroyed by me.</p>
<p>Date</p> <p>Record of Station</p> <p><u>Permissions obtained/observed taken by Trig operator</u></p>	

SI 2733-2 D. West, Government Printer

<p>STATION JACKAROSEY G.S. TS 2576</p>	<p>Owner's Name: Jeanette Hayer Address: GRANDPARK PROPERTY RANAKINE VIA BRANTON Phone: 47 4654</p> <p>Current Occupant: Jeanette Hayer Address: Phone: ACCESS 21st August 1979</p> <p>Access Report of 31/7/79 was found suitable/.....</p>
<p>Beacon Diagram</p>	<p>This section to be completed by officer constructing pillar.</p> <p>Original station mark found/.....</p> <p>Description of mark: Cartridge case</p> <p>Original beacon found/..... Note: 0.890 m. was cut off bottom of this mast due to wet rot.</p> <p>Description of beacon: Pole CALM 1.13m</p> <p>Height Top of Vanes to Top Mark: 4.260 m. /</p> <p>Height of mark: 0.24 m. above / 1.50 m. below G.L.</p> <p>Diameter of Vanes: 0.19 m. / Height of Calm: 1.130 m.</p> <p>Original Beacon has not been destroyed by me.</p>
	<p>Date</p> <p>Record of Station</p>