

GEODETIC SURVEY OF M.S.W.

CENTRAL MAPPING AUTHORITY


GEODETIC STATION RECONNAISSANCE and MAINTENANCE REPORT

STATION: JACKSON GS TS No.: 2577

MAP SHEET SCALE 1:250 000 CANBERRA

INSPECTED BY: W MILLER DATE: 7-3-79

AUTHORITY: CMA FIELD BOOK:

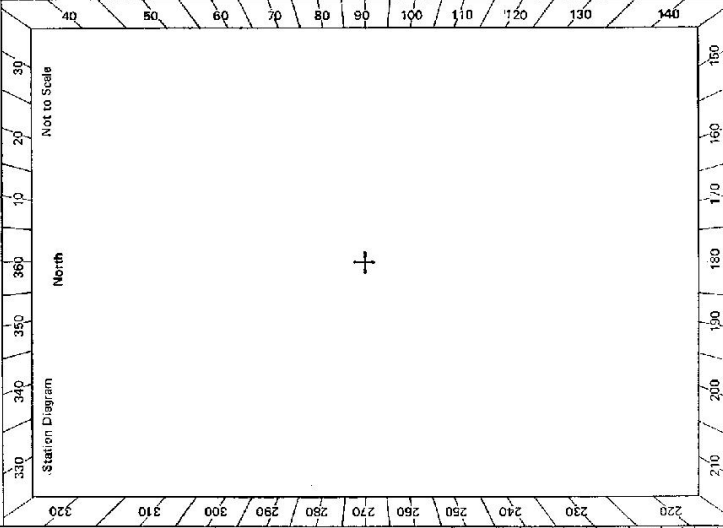

- Description:
1. Cleared by lanes bearing..... 360° Vision..... from Trig. Mast
Note: Cross out word or words which do not apply
 2. Mast & Vanes have been painted white & black respectively.
 3. The station/pillar was ~~erected~~/not unplied/constructed on..... 1.3..... 19.7.2..... dimensions now being:
Description of mark..... should be explicit, e.g., S/Steel Pillar Plate, Steel plug, Brass plug, Bolt, G.I. Pipe
Height of mark..... m. ^{above} rock/concrete; Mark is..... m. ^{above} G.I.L.
Height of Top Vanes to Top Mark/Pillar plate..... m. Diameter of Vanes (vertical)..... m.
Height of Cairn..... 10 m. Diameter of Cairn..... 10 m. Name Plate found/not found/placed.
Length of Mast..... m. (approximate if not unplied)
 4. A..... set in conc/rock has been placed/found, bearing..... °M from Mast/Plug/Pillar
 5. A..... set in conc/rock has been placed/found, bearing..... °M from Mast/Plug/Pillar
 6. A..... set in conc/rock has been placed/found, bearing..... °M from Mast/Plug/Pillar
 7. A..... set in conc/rock has been placed/found, bearing..... °M from Mast/Plug/Pillar
 8. Action required:.....

STANDPOINT:				
Mark	Direction	Horiz. Distance	Height Difference	Mark
			above standpt.	
			below standpt.	
			above standpt.	
			below standpt.	
Prepared by: W Miller 21-3-79 Checked: W Miller

Noted on U.T.M. Card

GS

<p>Owner's Name: Kossusko, Nations! Address: Park Phone:</p> <p>Current Occupant:</p>	<p style="text-align: center;">STATION JACKSON GS IS 2577</p> <p>ACCESS Report of 7.4.19.79. Notes found suitable/unstable.</p> <p style="text-align: right;">See 1:100000 Map OR 1:25000 if available.</p> <p style="text-align: right;">Scale 1:100000</p>
<p>Date: 13-79</p> <p>Record of Station: Marked</p>	<p>Record of Station</p>

8x2735-2 D. West, Government Printer

<p>Beacon Diagram</p>	<p>Not to Scale</p>
<p>This section to be completed by officer constructing pillar.</p> <p>Original station mark found/not found.</p> <p>Description of mark:</p> <p>Original beacon found/not found.</p> <p>Description of beacon:</p> <p>Height Top of Vanes to Top Markm.</p> <p>Height of markm. above G.L., below rock/conc.m. below</p> <p>Diameter of Vanesm. Height of Cairnm.</p> <p>Original Beacon has/has not been destroyed by me.</p>	