

STATION: **JACQUA G.S.** No: **2582**
 MAP SHEET **Goulburn**
 SCALE 1:250 000
 INSPECTED BY: **M.L. Macrossan** DATE: **21/10/18**
 AUTHORITY: **C.M.A.** FIELD BOOK: **1710**

Station Diagram

CENTRAL MAPPING AUTHORITY
 GEODETIC SURVEY OF N.S.W.
 GEODETIC STATION RECONNAISSANCE and MAINTENANCE REPORT

Description:
 1. Cleared by lanes bearing.....
 Note: Cross out word or words which do not apply

2. Mast & Vanes have been painted white & black respectively,
 3. The station/pillar was unpiled/not unpiled; constructed on.....19..... dimensions now being:

Description of mark..... should be explicit, e.g., S/Steel Pillar Plate, Steel plug, Brass plug, Bolt, G.I. Pipe
 Height of mark.....m. ^{above} _{below} rock/concrete; Mark is.....m. ^{above} _{below} G.L.

Height of Top Vanes to Top Mark/Pillar plate.....m. Diameter of Vanes (vertical).....m.
 Height of Cairn.....m. Diameter of Cairn.....m. Name Plate found/not found/placed.
 Length of Mast.....m. (approximate if not unpiled)

- 4. A..... set in conc/rock has been placed/found, bearing.....°M from Mast/Plug/Pillar
- 5. A..... set in conc/rock has been placed/found, bearing.....°M from Mast/Plug/Pillar
- 6. A..... set in conc/rock has been placed/found, bearing.....°M from Mast/Plug/Pillar
- 7. A..... set in conc/rock has been placed/found, bearing.....°M from Mast/Plug/Pillar
- B. Action required.....

Report

*Top pt in poor condition. Cairn OK. Needs new mast and vanes
 no other marks pd. Hill could be broad, leg lanes to the east and
 to the south. It would be easier to clear hills seen as possible as there
 has been a fire through the area and all surrounding ranges can be seen
 and it is easy walking for clearing*

Prepared by: **MS/1178** Checked: **MS/1178** Named on U.T.M. Grid

STATION **JACQUA G.S. TS 2582**


Owner's Name:
 Address:
 Phone:
 Current Occupant:
 Address:
 Phone:

ACCESS

Access Report of 21/10/18 was found suitable/unsuitable.

Direction

- 0.00 Old Bungonia school. Head south towards Windelkams
- 4.25 Turn right onto road to Taraco 38
- 11.45 Turn right sign Bungonia Heights Estate land sale
- 12.30 Pass road on right
- 13.00 Turn right up fence line. large dam on your left.
- 13.58 Turn right through fence.
- 13.60 JACQUA G.S.

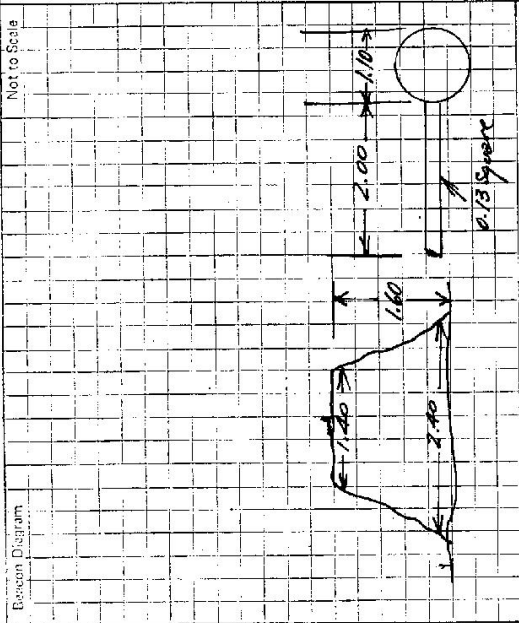

This section to be completed by officer constructing pillar.

Original station mark found/not found.

Description of mark:

Original beacon found/not found.

Description of beacon:

Height Top of Vane to Top Mark:m.

Height of mark:m. above G.L. below rock/cone

Diameter of Vane:m. Height of Cairn:m.

Original Beacon has/has not been destroyed by me.

Date	Record of Station

GEODETIC SURVEY OF N.S.W.

CENTRAL MAPPING AUTHORITY

GEODETIC STATION RECONNAISSANCE and MAINTENANCE REPORT

STATION: **JACQUA** No: **2582**
 MAP SHEET SCALE 1:250 000 **GOULBURN**
 INSPECTED BY: **R. ELLIS** DATE: **06-03-01**
 AUTHORITY: **C. M. A.** FIELD BOOK: **2135**

- Description: *Note: Cross out word or words which do not apply*
- ~~Cleared by James-bearing~~ *High* ~~Corrections~~ *Corrected* ~~from Trig. Mast~~
 - ~~Mast & Vanes have been painted white & black respectively.~~
 - The station/pillar was ~~unpiled~~/~~constructed~~ on ~~CE~~ *19.87* m, dimensions now being: ~~Should be explicit, eg, S/Steel Pillar Plate, Steel Plug, Brass Plug, Bolt, G.I. Pipe~~
- Description of mark: ~~Block~~ *Block* ~~above~~ *above* rock/concrete; ~~below~~ *below* G.L.
- Height of mark: ~~.....m.~~ *.....m.*
- Height of Top Vanes to Top Mark/Pillar plate: ~~.....m.~~ *.....m.* Diameter of Vanes (vertical) ~~.....m.~~ *.....m.*
- Height of Cairn: ~~.....m.~~ *.....m.* Diameter of Cairn: ~~.....m.~~ *.....m.* Name Plate found/not found/placed.
- Length of Mast: ~~.....m.~~ *.....m.* (approximate if not unpiled)
- A ~~.....~~ set in conc/rock has been placed/found, bearing.....°M from Mast/Plug/Pillar
 - A ~~.....~~ set in conc/rock has been placed/found, bearing.....°M from Mast/Plug/Pillar
 - A ~~.....~~ set in conc/rock has been placed/found, bearing.....°M from Mast/Plug/Pillar
 - A ~~.....~~ set in conc/rock has been placed/found, bearing.....°M from Mast/Plug/Pillar

8. Action required: ~~GOOD TRIG. SITE~~ *THOUGH EXCESSIVE CLEARANCE REQUIRED - PROBABLY OWNED LAND*
 SEE * NOTE ON BACK.

STANDPOINT:

Mark	Direction	Horiz. Distance	Height Difference	Mark	Direction	Horiz. Distance	Height Difference
			above standpt.				above standpt.
			below				below
			above standpt.				above standpt.
			below				below
Prepared by: *Ellis 7/1/01* Checked: *.....* Noted on U.T.M. Card

GEODETIC SURVEY OF M.S.W

CENTRAL MAPPING AUTHORITY

GEODETIC STATION RECONNAISSANCE and MAINTENANCE REPORT

- Description: *Note: Cross out word or words which do not apply*
- Cleared by lanes bearing 110° 18' 10" N from Trig. Mast
 - Mast & Vanes have been painted white & black respectively X
 - The station/~~pillar~~ was ~~unplaced~~/~~not unplaced~~/~~conspicuous~~ on 23 May 1984, dimensions now being: ROCK LANT, MAST & VANES IS BY M.C. GUNDA
Description of mark..... should be explicit, e.g., S/Steel Pillar Plate, Steel plug, Brass plug, Bolt, G.I. Pipe
Height of mark.....m, above rock/concrete; Mark is.....m, above, below G.L.
Height of Top Vanes to Top Mark/Pillar plate.....m. Diameter of Vanes (vertical).....m.
Height of Cairn.....m. Diameter of Cairn.....m. Name Plate ~~found~~/~~not found~~/~~placed~~.
Length of Mast.....m. (approximate if not unplaced)
 - A.....set in conc/rock has been placed/found, bearing.....° M from Mast/Plug/Pillar
 - A.....set in conc/rock has been placed/found, bearing.....° M from Mast/Plug/Pillar
 - A.....set in conc/rock has been placed/found, bearing.....° M from Mast/Plug/Pillar
 - A.....set in conc/rock has been placed/found, bearing.....° M from Mast/Plug/Pillar
 - Action required:.....


STANDPOINT:

Mark	Direction	Horiz. Distance	Height Difference	Mark	Direction	Horiz. Distance	Height Difference
			above standpt.				above standpt.
			below standpt.				below standpt.
			above standpt.				above standpt.
			below standpt.				below standpt.
Prepared by: D. J. KALW. Checked: [Signature]

Noted on U.T.M. Card

SR 2733-1

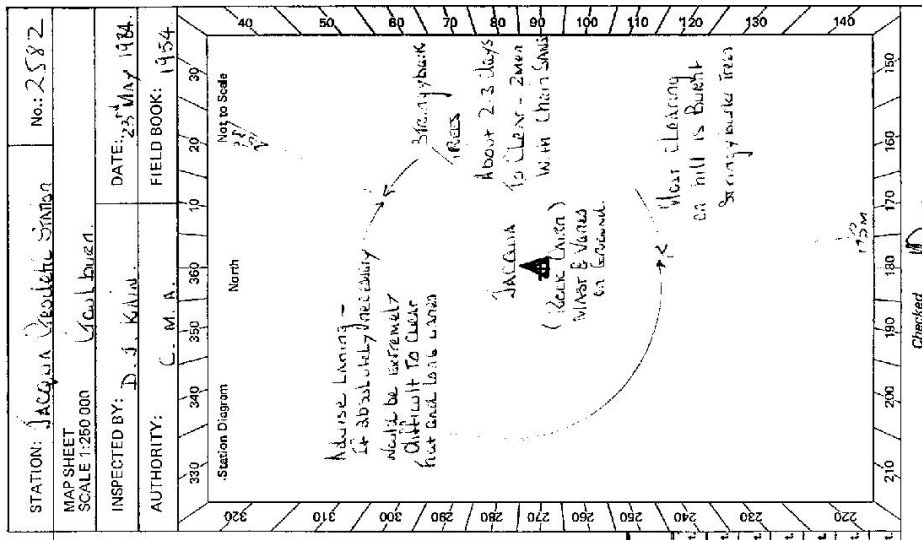

Checked: [Signature]

STATION: JALANA Geodetic Station No: 2582
MAP SHEET SCALE: 1:250 000
INSPECTED BY: D. J. KALW. DATE: 23 May 1984.
AUTHORITY: C. M. A. FIELD BOOK: 1934


RS 2733-2 D. West, Government Printer

STATION **JACQUA Geodetic Station JS 2582**

Owner's Name: **R. M. S. R. F. Dale**
 Address: **237 KISSING POINT ROAD, DUNDAS 2417**
 Phone: **(027) 628 5826**
 Current Occupant:
 Address:
 Phone:
 ACCESS **23-5-1984**

Access Report of **21/10/1976** was found **unsuitable**.

- FEASIBLE**
- 0.00 At Post Office Bungalow on January Road, Travel towards Middleburg.
 - 0.16 Turn Left towards Middleburg.
 - 4.39 Turn Right, Inlets, BUNCONIA HTS. 7.
 - 11.63 Turn Right into BLANKES BVD.
 - 12.50 Turn Right up TRINGLEWOOD CLOSE.
 - 13.05 Turn Right through Iron Gate, follow gravel track up hill.
 - 13.28 Pass CAVERN AND Tin Shed on X-axis U.I.S. Continue straight ahead.
 - 13.74 JACQUA - Geodetic Station.

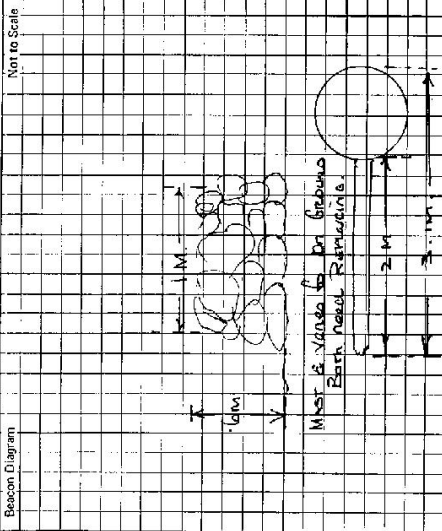

This section to be completed by officer constructing pillar.


Original station mark found/not found.
 Description of mark:
 Original beacon found/not found.
 Description of beacon:
 Height Top of Varies to Top Markm.
 Height of markm. above rock/conem. above G.L. Below
 Diameter of Variesm. Height of Cairnm.
 Original Beacon has/has not been destroyed by me.

Date	Record of Station

2733-2 D. West, Government Printer

FEB 1995

STATION JACQUA Geodetic Station. IS 2582

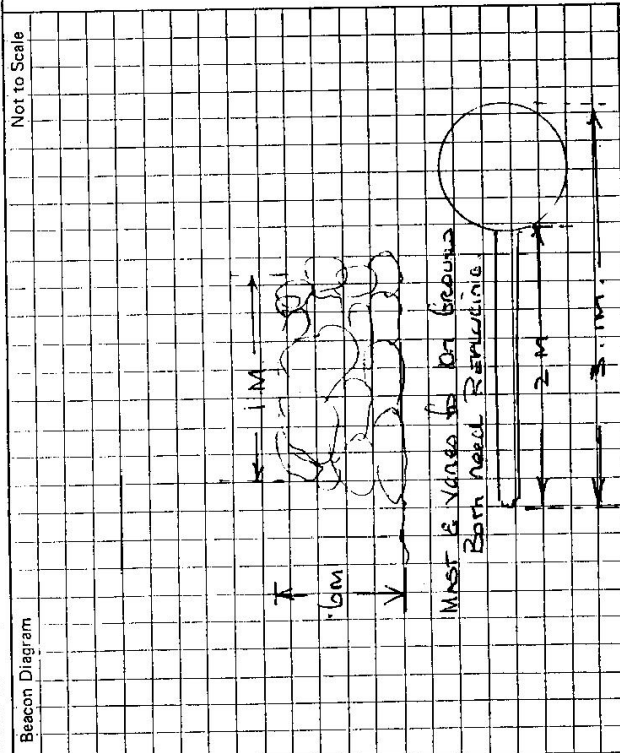

Geohold
 Owner's Name: R.M. & R.E. Dole
 Address: 231 Kissimmee Point Road,
 Phone: 407-622-5272

OWNER: R.M. & R.E. DOLE
 Current Occupant: TANGLEWOOD CLOSE
 Address: VIA BUNGOMIA
 Phone: 048 487 179

ACCESS 23-5-1984

Access Report of 7/10/1974 was found suitable/unsuitable.

- 0.00 KMS At Post While Bungonia on Inveray Road, travel toward Windellama.
- 0.16 Turn Left toward Windellama.
- 4.39 Turn Right, Tarago, Bungonia Hts.7.
- 11.63 Turn Right into Blakes Blvd.
- 12.50 Turn Right up Tanglewood Close.
- 13.05 Turn Right through Iron Gate, follow Good gravel track up hill.
- 13.28 Pass Caravan and Tin shed on Your L.H.S. Continue straight ahead, new house there go around R.H.S.
- 13.74 JACQUA - Geodetic Station.

This section to be completed by officer constructing pillar.

Original station mark found/not found.

Description of mark:

Original beacon found/not found.

Description of beacon:

Height Top of Vane to Top Mark.....m.

Height of mark.....m. above G.L.
 below

Diameter of Vane.....m.

Height of Cairn.....m.

Original Beacon has/has not been destroyed by me.

Date	Record of Station