
GEODETIC STATION I         Description:       Not         1.       Cleared by lanes bearing         2.       Mast & Vanes have been painted white & black respectively.									
Description: Lescription: Cleared by lanes bearing 2. Mast & Vanes have been p	GE	EODETIC STATION	GEODETIC STATION RECONNAISSANCE and MAINTENANCE REPORT	nd MAINTEN₽	ANCE REP(	DRT	STATION:	JADAR	No.: 2 583
<ul> <li>Cleared by lanes bearing</li> <li>Mast &amp; Vanes have been p</li> </ul>		Nc	Note: Cross out word or words which do not apply	iords which do	not apply		MAP SHEET SCALE 1:250 000	TANTANGARA	RA 1: 100,000
2. Mast & Vanes have been p				from Trig. Mast	g. Mast		INSPECTED BY:	R. COOK	DATE: 7-3-79
	oainted white	. & black respectively					AUTHORITY:	C. M. A.	FIELD BOOK:
3. The station/pillar was unpiled/not unpiled/constructed on19 19 dimensions now being:	oiled/not unp	iled/constructed on.	19	, dimensions n	iow being:		ghe yes	350 380	10 / 20 / 39'
Description of markshould be explicit, e.g., S/Steel Pillar Plate, Steel plug, Brass plug, Bolt, G.I. Pipe	Plate sh	ould be explicit, e.g.	, S/Steel Pillar Plate, Ste	el plug, Brass p	ilug, Bolt, G	.l. Pipe	Station Diagram	North	Not to Scale
Height of markm. belowe rock/concrete;	m. <sup>above</sup> roc	ik/concrete;	Mark is m. above G.L.	oove G.L.			_		
Height of Top Vanes to Top Mark/Pillar	op Mark/Pill	ar platem.		Diameter of Vanes (vertical)m.	ical)	Ľ	0		
Height of Cairnm.	m.		Diameter of Cairnm.	Name Plate found/not found/placed.	d/not foun	d/placed.	16 /		
Length of Mastm.	Ľ	(approximate if not unpiled)	t unpiled)				000		
<ol> <li>A. A</li></ol>	.set in conc/r	ock has been placed.	'found, bearing	M from Mast,	/Plug/Pillar		: / 0		
5. A	.set in conc/r	ock has been placed,	/found, bearing	M from Mast	/Plug/Pillar		6ź /		
<ol> <li>A<sup>6</sup>M from Mast/Plug/Pillar</li> <li>A<sup>6</sup>M from Mast/Plug/Pillar</li> </ol>	set in conc/r	ock has been placed,	/found, bearing	M from Mast	/Plug/Pillar		09Z		
7. A	.set in conc/r	ock has been placed,	found, bearing	M from Mast	/Plug/Pillar		012	+	
8. Action required: PART. DE. HANES. MISSING, Survey and by Light Himber. Purch . Drug to . 12.	C. LANG. M	USSANG, SULMANA	of by sight timbe	A. Augle	Drue to		560		
STANDPOINT:			STANDPOINT:						
Mark	ion Distance	e Height Difference	Mark	Direction	Horiz. Distance	Height Difference	sz \		
		above standpt below				above standpt.	240		
		above standpt. below				above below standpt.			
		above standpt.				above below standpt	530		
		above standpt. below				above standpt. below			
		above standpt. below				above standpt.			
		above standpt. helow				below standpt.	izz		
		above standpt. below				above standpt.	210 / 200	190 180	170 160 150
Prepared by: Reference	. Cart	Checked:		Wat	Noted on U. T.M. Card	. Card		Checked	

......

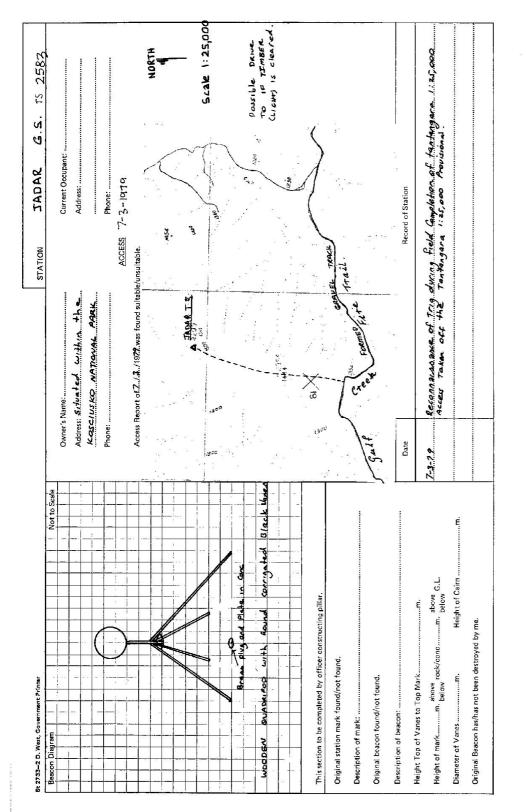

\_\_\_\_\_

. ....