

CENTRAL MAPPING AUTHORITY

JAMISON

GEODETIC SURVEY OF M.S.W.
 GEODETIC STATION RECONNAISSANCE and MAINTENANCE REPORT

STATION: *Jamison S.S.* No: *2587*

Description:
 1. Cleared by lanes bearing..... *Note: Cross out word or words which do not apply*..... from Trig. Mast

2. Mast & Vanes have been painted white & black respectively.

3. The station/pillar was unpiled/not unpiled/constructed on..... 19....., dimensions now being:
 Description of mark..... should be explicit, e.g., S/Steel Pillar Plate, Steel plug, Brass plug, Bolt, G.I. Pipe
 Height of mark..... m. above below rock/concrete; Mark is..... m. above below G.L.

Height of Top Vanes to Top Mark/Pillar plate..... m. Diameter of Vanes (vertical)..... m.
 Height of Cairn..... m. Diameter of Cairn..... m. Name Plate found/not found/placed.

Length of Mast..... m. (approximate if not unpiled)

4. A..... *Set in conc/rock* has been placed/found, bearing..... ° M from Mast/Plug/Pillar

5. A..... *Set in conc/rock* has been placed/found, bearing..... ° M from Mast/Plug/Pillar

6. A..... *Set in conc/rock* has been placed/found, bearing..... ° M from Mast/Plug/Pillar

7. A..... *Set in conc/rock* has been placed/found, bearing..... ° M from Mast/Plug/Pillar

8. Action required:.....


STANDPOINT:
 Mark Direction Horiz. Distance Height Difference

Mark	Direction	Horiz. Distance	Height Difference
			above standpt.
			below standpt.
			above standpt.
			below standpt.
Prepared by: *[Signature]* Checked: *[Signature]*
 Noted on U.T.M. Card

Station Diagram

MAP SHEET SCALE 1:250 000
 INSPECTED BY: *AL Morris* DATE: *20/1/78*
 AUTHORITY: *C.M.A.* FIELD BOOK: *1711*

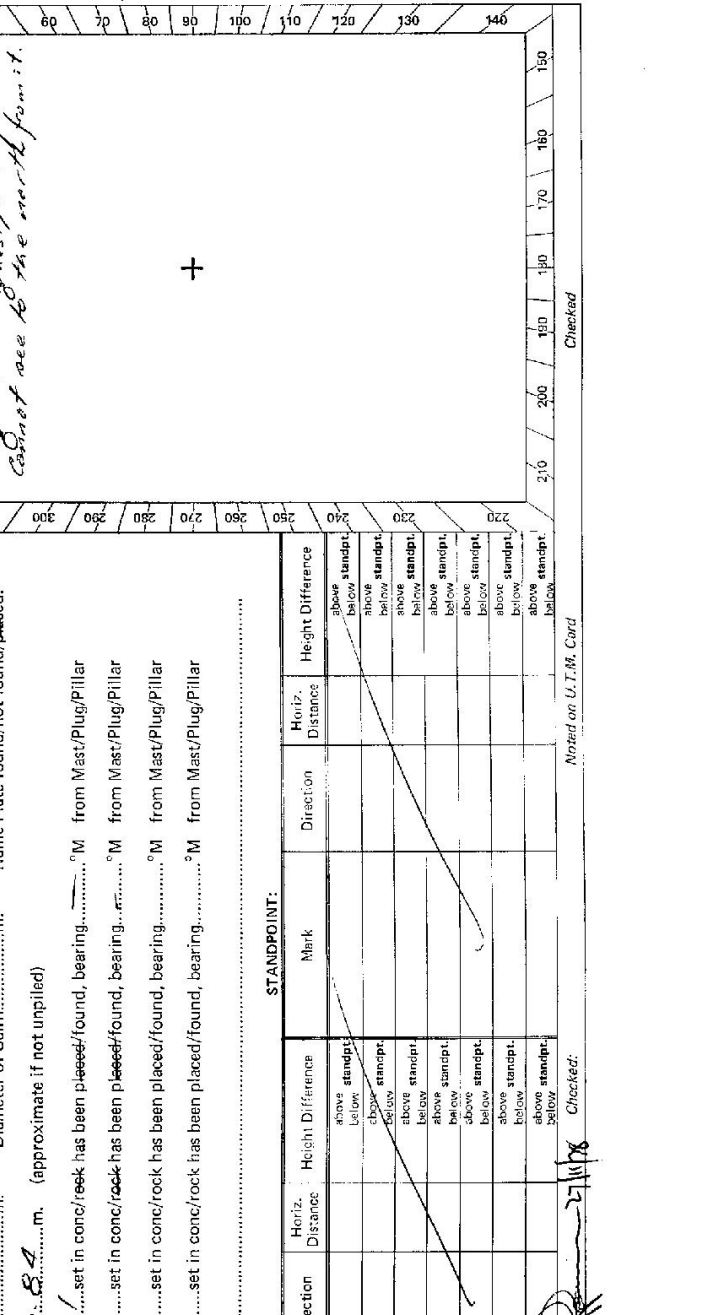


Not to Scale

Checked

STATION **JAMIESON IS 2587**

Owner's Name: **Peter Webb**
 Address: **SHANKERS' TARALKA**
 Phone:
 Current Occupant:
 Address:
 Phone:
 ACCESS

Access Report of 20/11/1988 was found suitable/unsuitable.
 Km **Direction**
 0.00 **TARALGA RD. HEAD NTH TOWARDS OBERON**
 2.30 **TURN RIGHT INTO DIRT RD**
 3.50 **GRID + GATE + CONCRETE CAUSEWAY**
 4.50 **" + "**
 4.90 **GATE FOLLOW MAIN TRACK**
 5.70 **GATE SHANKERS' FOLLOW TRACK TO SHEDS + TURN RIGHT**
 5.90 **TRIG.**

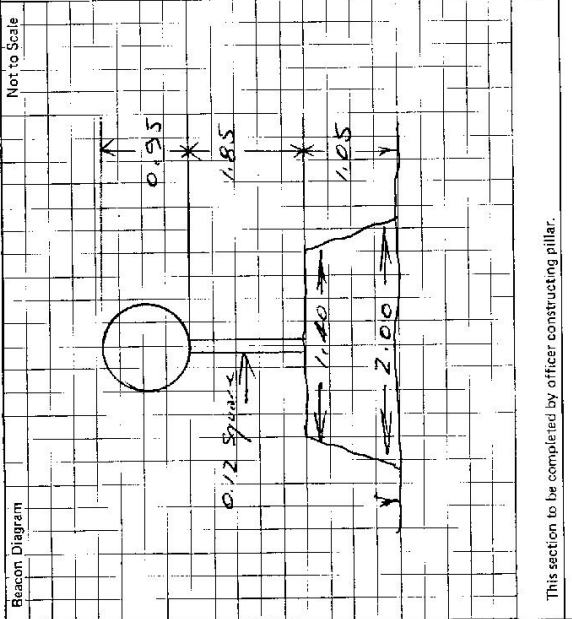

This section to be completed by officer constructing pillar.
 Original station mark found/not found.
 Description of mark:
 Original beacon found/not found.
 Description of beacon:
 Height: Top of Vanes to Top Markm.
 Height of mark:m. above G.L. below
 Diameter of Vanesm. Height of Cairnm.
 Original Beacon has/has not been destroyed by me.

Date	Record of Station