

LOCALITY SKETCH PLAN



TS2592

Local Government Area THE HILLS SHIRETown/Suburb/Locality ANNANGROVE


Approx MGA Coordinate: Zone _____

Description of Mark _____

Plug in concrete _____

E: _____

N: _____

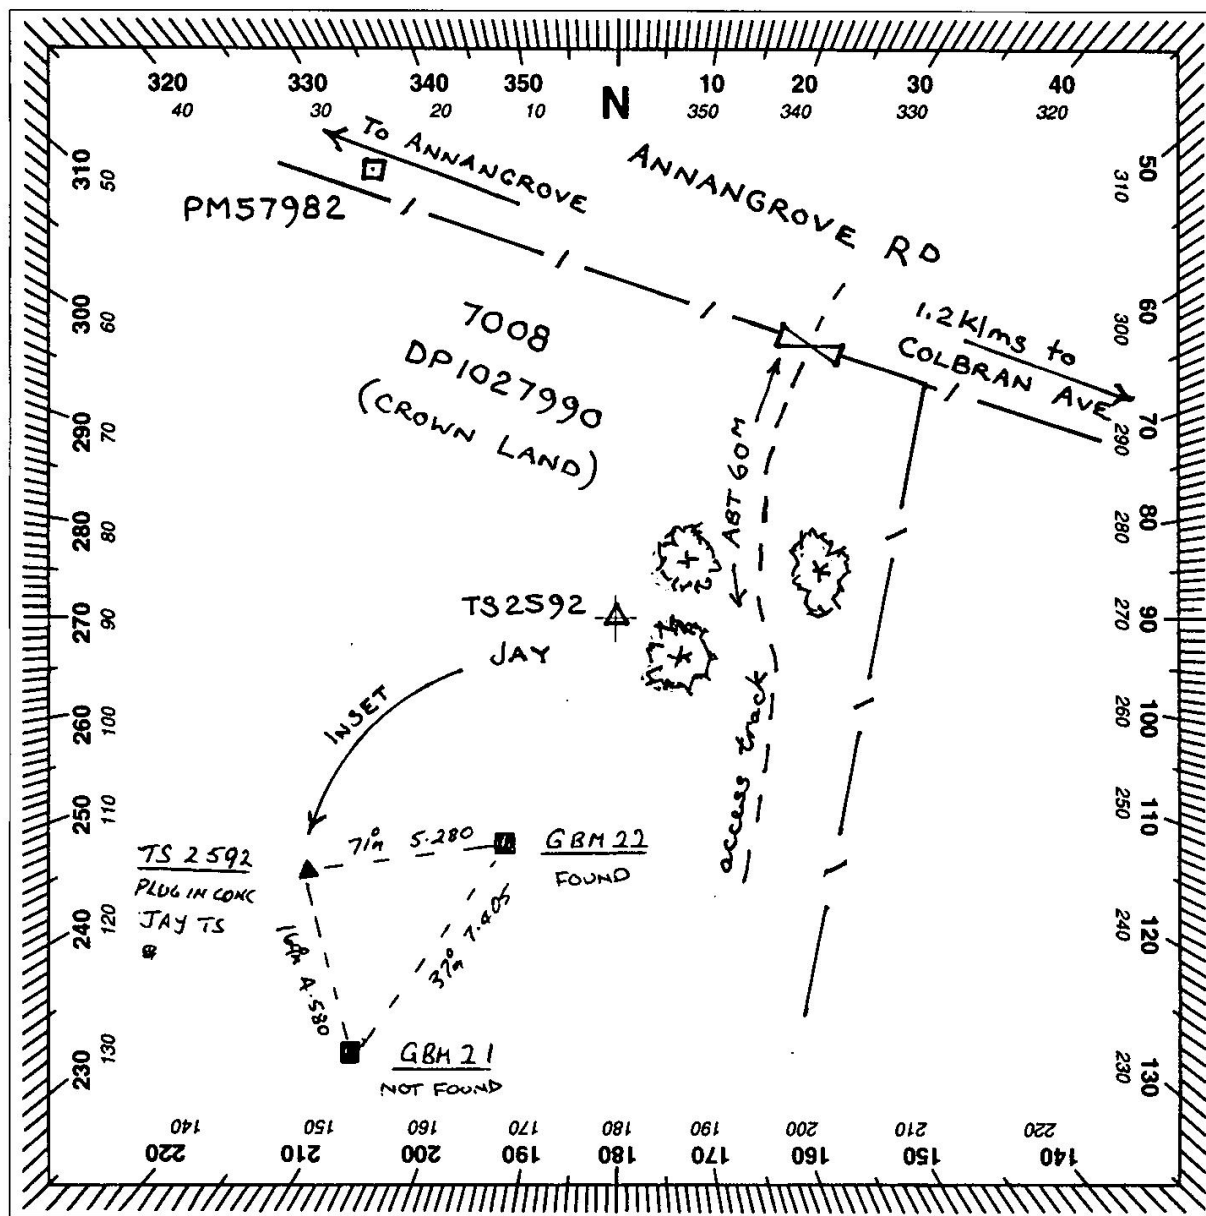

Please use black ink only

SURVEYING REGULATION			
MARK	AHD	SOURCE	DATE
HEIGHT DETERMINED BY - DIFF. LEVELLING (Specify) - TRIG HEIGHTING			
ADOPTED MARKS - GPS			

Measurements are in metres

PM

TS 2592

PM

Replaces

SS

I certify that the mark has been placed found and numbered as detailed hereon.

Signed: _____

Name: MICHAEL LONDONOrganisation LPMADate mark placed found: 27/10/2010

Ref: _____