

CENTRAL MAPPING AUTHORITY

Department of Lands

Trigonometrical Survey of N.S.W.

RECONNAISSANCE and MAINTENANCE REPORT

This Trig. Station has been:-

Note: Cross out word or words which do not apply

1. ~~Completely cleared to permit 360° vision to surrounding Trig.~~
2. Cleared by lines bearing 80° NORTH from Trig. Mast
3. Trig. Mast & Vanes ~~have been painted white & black respectively.~~ Mast rotten
3 vanes gone
4. The Trig. was ~~emptied~~/not unpiled, dimensions now being: Original Station Mast
razed & repaired

Description of mark..... should be explicit, e.g. Steel plug, Brass plug, Bolt, G.I. Pipe

Height of mark..... m above rock/concrete m below G.L.

Height of Top Vanes to Top Mark..... m. Diameter of Vanes (vertical)..... m.

Height of Cairn..... m. Diameter of Cairn..... m.

Length of Mast..... m. (approximate if not unpiled)

5. A..... set in conc/rock has been placed..... m. bearing..... °M from Trig. Mast
6. A..... set in conc/soil has been placed..... m. bearing..... °M from Trig. Mast
7. A..... set in conc/soil has been placed..... m. bearing..... °M from Trig. Mast
8. A..... set in conc/rock has been placed..... m. bearing..... °M from Trig. Mast

9. Connection..... to..... m. bearing..... °M
10. Connection..... to..... m. bearing..... °M
11. Connection..... to..... m. bearing..... °M
12. Connection..... to..... m. bearing..... °M

13. Diff. Ht. is..... m. above below
14. Diff. Ht. is..... m. above below
15. Diff. Ht. is..... m. above below
16. Diff. Ht. is..... m. above below

Prepared by: A. Talbot Checked: _____

Noted on U.T.M. Card

STATION JERRA NEW TS 2601


Co: Goulburn Ph: Jerra Jerra

Map Sheet: Wagga Wagga No: 8327

Inspected by: A. Talbot A.T.S. Date: Aue '76

Authority Geodetic Survey C.M.A. Field Book:

Beacon Diagram Not to Scale

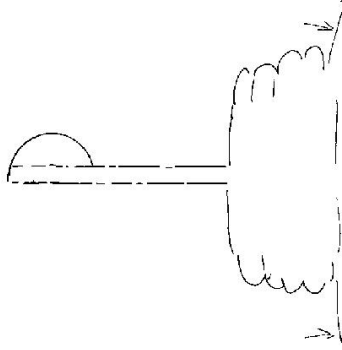

Date

Record of Station

Checked

