

CENTRAL MAPPING AUTHORITY

Department of Lands

Trigonometrical Survey of N.S.W.

RECONNAISSANCE and MAINTENANCE REPORT

This Trig. Station has been:-

Note: Cross out word or words which do not apply


1. Completely cleared to permit 360° vision to surrounding Trigs.
2. Cleared by lances bearing 45° to 100°M from Trig. Mast
3. Trig. Mast & Vanes have been painted white & black respectively.
4. The Trig. was unpiled/not unpiled, dimensions now being:

Description of mark..... should be explicit, e.g. Steel plug, Brass plug, Bolt, G.I. Pipe  
 Height of mark..... m above rock/concrete ..... m below G.L.  
 Height of Top Vanes to Top Mark..... m Diameter of Vanes (vertical) 0.765 m.  
 Height of Cairn 1.65 m. Diameter of Cairn 2.2 m.  
 Length of Mast 3.76 m. m. (approximate if not unpiled)

5. A..... set in conc/rock has been placed..... m. bearing.....°M from Trig. Mast
6. A GI PIPE..... set in conc/soil has been placed 1.787..... m. bearing 271°M.....°M from Trig. Mast
7. A..... set in conc/soil has been placed..... m. bearing.....°M from Trig. Mast
8. A..... set in conc/rock has been placed..... m. bearing.....°M from Trig. Mast
9. Connection..... to..... m. bearing.....°M
10. Connection..... to..... m. bearing.....°M
11. Connection..... to..... m. bearing.....°M
12. Connection..... to..... m. bearing.....°M
13. Diff. Ht. GI PIPE PLACED is 4.095 m. above Bottom of Vanes JIMENBUEN G.S.
14. Diff. Ht. is..... m. above below
15. Diff. Ht. is..... m. above below
16. Diff. Ht. is..... m. above below

Prepared by: Alex Woodruff Checked: A.W. Woodruff Noted on U.T.M. Card

STATION JIMENBUEN G.S. TS 2619  
 Co: No: 8624  
 Map Sheet: NJMBLA Date: 28/1/77  
 Inspected by: A. WOODRUFF Field Book: 1530  
 Authority: C.M.A. Not to Scale  
 Beacon Diagram

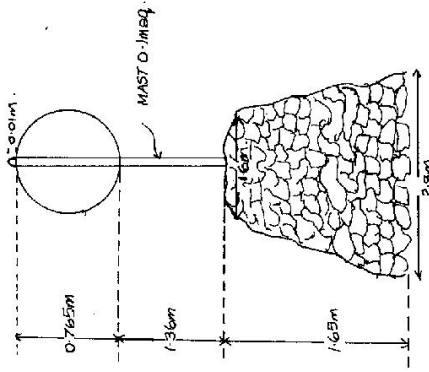

Date  
 Record of Station

Checked Examined A Woodruff 24/3/73

