

CENTRAL MAPPING AUTHORITY

GEODETIC SURVEY OF N.S.M.

GEODETIC STATION RECONNAISSANCE and MAINTENANCE REPORT

STATION: **JINERO** No: **2624**

Description:

1. Cleared by ~~hoses~~ **beering** *AD clearing done at 11/11* Note: *Cross out word or words which do not apply*

2. ~~Mast & Vanes have been painted white & black respectively.~~ **Mast & Vanes have been painted white & black respectively.**

3. The station/pillar was unpiled/not unpiled/constructed on **19** dimensions now being:

Description of mark **should be explicit, e.g., S/Steel Pillar Plate, Steel plug, Brass plug, Bolt, G.I. Pipe**

Height of mark **above rock/concrete; Mark is above m. below G.L.**

Height of Top Vanes to Top Mark **3.3** m. Diameter of Vanes (vertical) **0.9** m.

Height of Cairn **1** m. Diameter of Cairn **2.4** m. Name Plate found/not found/placed.

Length of Mast **3** m. (approximate if not unpiled)

4. **SSM** set in conc/rock has been placed/found, bearing **222** °M from Mast/Plug/Pillar


5. **A** set in conc/rock has been placed/found, bearing **.....** °M from Mast/Plug/Pillar

6. **A** set in conc/rock has been placed/found, bearing **.....** °M from Mast/Plug/Pillar

7. **A** set in conc/rock has been placed/found, bearing **.....** °M from Mast/Plug/Pillar

8. Action required: **Needs new vanes, mast & base major clearing in mechanism/height set up.**

MAP SHEET SCALE 1:250 000
 INSPECTED BY: **S. CAYNOR** DATE: **24.7.81**
 AUTHORITY: **CMA** FIELD BOOK:

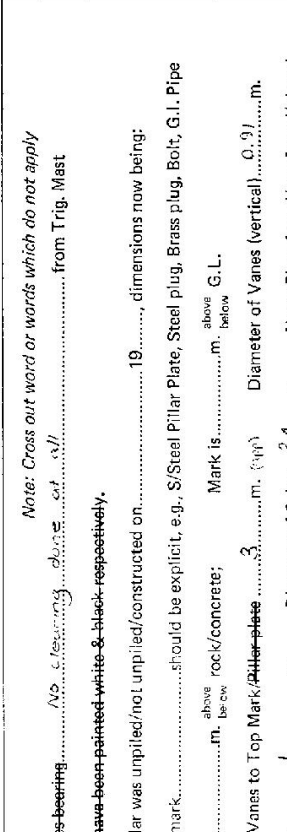

STANDPOINT:			
Mark	Direction	Horiz. Distance	Height Difference
			above standpt.
			below
			above standpt.
			below
Prepared by: *[Signature]* Checked: *[Signature]*
 Noted on L.T.M. Card
 15.3.85 Checked

CS 24


STATION JINEIRO TS 2624

Owner's Name: Forrest, Garry Current Occupant:
 Address: Address:
 Phone: Phone:

ACCESS

Access Report of 24/9/1981 was found suitable/unsuitable.

- 00 00 Captain's Flat PC Head towards Snowwood
- 00 09 Take right fork towards Brownwood
- 00 57 Gravel Sheds
- 03 94 Turn left - Sign "Harolds Cross"
- 10 15 Turn left - "Main Range Forest Road"
- 10 75 Pass track on right
- 11 88 Pass track on right
- 12 20 Pass track on right
- 12 37 Fork left off "Main Range F.R." onto dirt track
- 12 37 TRIG is 2m off track on right

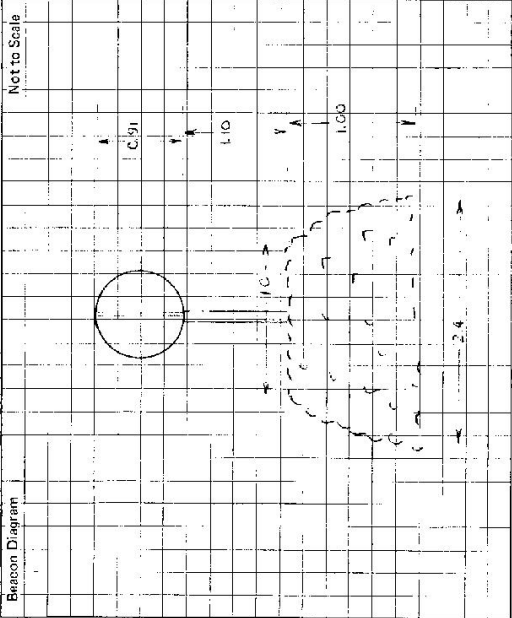

This section to be completed by officer constructing pillar.

Original station mark found/not found.

Description of mark:

Original beacon found/not found.

Description of beacon:

Height Top of Vanes to Top Mark:m.

Height of mark:m. above rock/cont.m. below G.L.

Diameter of Vanes:m. Height of Cairn:m.

Original Beacon has/has not been destroyed by me.

Date	Record of Station