

GEODETIC SURVEY OF NSW


CENTRAL MAPPING AUTHORITY

GEODETIC STATION RECONNAISSANCE and MAINTENANCE REPORT

STATION: **JOBBINS** No.: **2628**

Description: *Note: Cross out word or words which do not apply*

1. Cleared by lanes bearing..... from Trig/Mast
2. Mast & Vanes have been painted white & black respectively.
3. The station/pillar was unpiled/not unpiled/constructed on..... 19..... dimensions now being:  
Description of mark..... should be explicit, e.g., S/Steel Pillar Plate/Steel plug, Brass plug, Bolt, G.I. Pipe  
Height of mark.....m. <sup>above</sup>/<sub>below</sub> rock/concrete; Mark is <sup>above</sup>/<sub>below</sub> G.L.
- Height of Top Vanes to Top Mark/Pillar plate .....m. Diameter of Vanes (vertical).....m.
- Height of Cairn.....m. Diameter of Cairn.....m. Name Plate found/not found/placed.
- Length of Mast.....m. (approximate if not unpiled)
4. A..... set in conc/rock has been placed/found, bearing.....°M from Mast/Plug/Pillar
5. A..... set in conc/rock has been placed/found, bearing.....°M from Mast/Plug/Pillar
6. A..... set in conc/rock has been placed/found, bearing.....°M from Mast/Plug/Pillar
7. A..... set in conc/rock has been placed/found, bearing.....°M from Mast/Plug/Pillar
8. Action required:.....

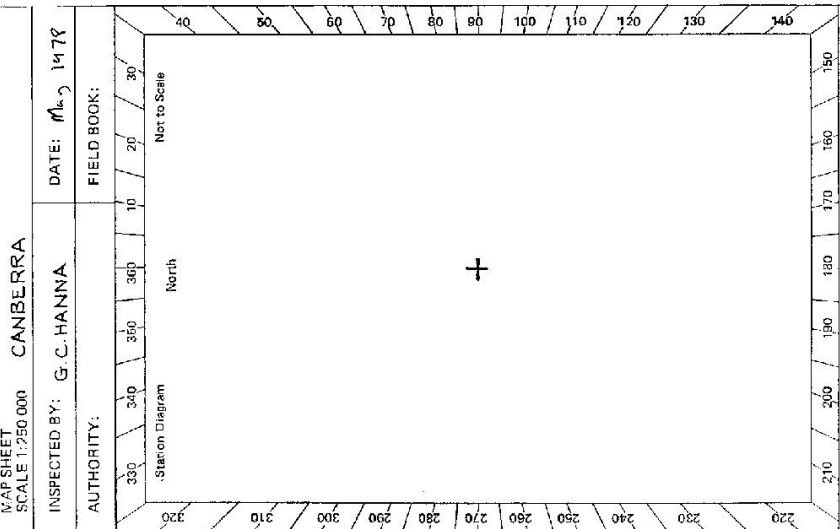


STANDPOINT:

Mark	Direction	Horiz. Distance	Height Difference	Mark	Direction	Horiz. Distance	Height Difference
			above standpt.				above standpt.
			below standpt.				below standpt.
			above standpt.				above standpt.
			below standpt.				below standpt.
			above standpt.				above standpt.
			below standpt.				below standpt.
			above standpt.				above standpt.
			below standpt.				below standpt.

Prepared by: *G. Hannas* Checked: *G. Hannas* Noted on U.T.M. Card

8c2735-2 D. West, Government Printer

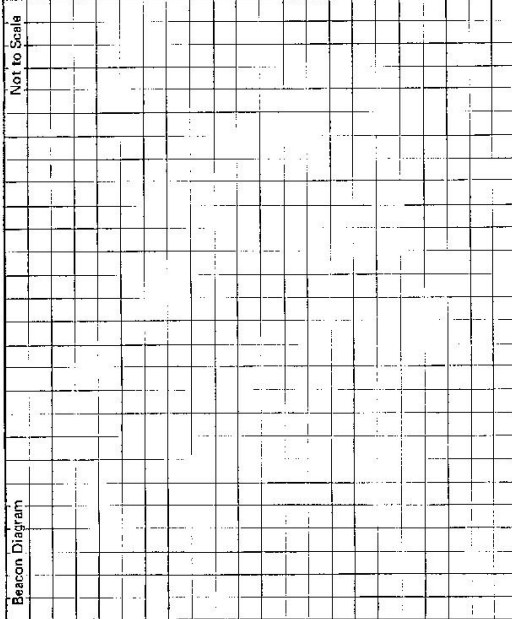STATION	JOBIBNS	TS 2628
<p>Owner's Name: .....</p> <p>Address: .....</p> <p>Phone: .....</p> <p>Access Report of: <i>May 1978</i> ..... was found suitable/unsuitable.</p> <p><i>ACCESS</i></p> <p><i>Drive to trig</i></p> <p><i>Rock cairn found. Mast &amp; vanes destroyed</i></p> <p><i>360° vision with removal of several close medium trees</i></p> <p><i>For access see Bedulluck 8727-N-N</i></p>	<p>Current Occupant: .....</p> <p>Address: .....</p> <p>Phone: .....</p>	<p>Not to Scale</p> 
<p>This section to be completed by officer constructing pillar.</p> <p>Original station mark found/not found.</p> <p>Description of mark: .....</p> <p>Original beacon found/not found.</p> <p>Description of beacon: .....</p> <p>Height Top of Vane to Top Mark.....m.</p> <p>Height of mark.....m. above rock/cont.....m. below G.L.</p> <p>Diameter of Vane.....m. Height of Cairn.....m.</p> <p>Original Beacon has/has not been destroyed by me.</p>		
Date	Record of Station	