

GEODETTIC SURVEY OF M.S.W.

CENTRAL MAPPING AUTHORITY

GEODETTIC STATION RECONNAISSANCE and MAINTENANCE REPORT

- Description:
1. Cleared by lanes bearing..... *See over* ..... from Trig. Mast
  2. Mast & Vanes have been painted white & black respectively.
  3. The ~~station~~/~~pillar~~ was ~~unplaced~~/~~not unplaced~~/~~constructed~~ on..... *5.7.7.19* ..... dimensions now being:  
Description of mark..... should be explicit, e.g., S/Steel Pillar Plate, Steel plug, Brass plug, Bolt, G.I. Pipe  
Height of mark.....m. <sup>above</sup> rock/concrete; Mark is.....m. <sup>above</sup> G.L.  
Height of Top Vanes to Top Mark/Pillar plate .....m. Diameter of Vanes (vertical).....m.  
Height of Cairn.....m. Diameter of Cairn.....m. Name Plate found/not found/placed.  
Length of Mast.....m. (approximate if not unplied)
  4. A.....set in conc/rock has been placed/found, bearing.....° M from Mast/Plug/Pillar
  5. A.....set in conc/rock has been placed/found, bearing.....° M from Mast/Plug/Pillar
  6. A.....set in conc/rock has been placed/found, bearing.....° M from Mast/Plug/Pillar
  7. A.....set in conc/rock has been placed/found, bearing.....° M from Mast/Plug/Pillar
  8. Action required:..... *Continued Maintenance of Beacon & Pillar Only* .....

STANDPOINT:

Mark	Direction	Horiz. Distance	Height Difference	Mark	Direction	Horiz. Distance	Height Difference
			above standpt.				above standpt.
			below				below
			above standpt.				above standpt.
			below				below
Prepared by: *Pat M...*


9.8.78. Checked:

Noted on U.T.M. Card

SI 2733-1

STATION: *SONDARYAN* No.: *2635*  
 MAP SHEET SCALE 1:250 000 *NARRANDERA*  
 INSPECTED BY: *P. Naylor* DATE: *15.7.77*  
 AUTHORITY: *C.M.A.* FIELD BOOK:  
 Station Diagram  
 North  
 Not to Scale  
 Checked

Sr-2738-2 D. West, Government Printer

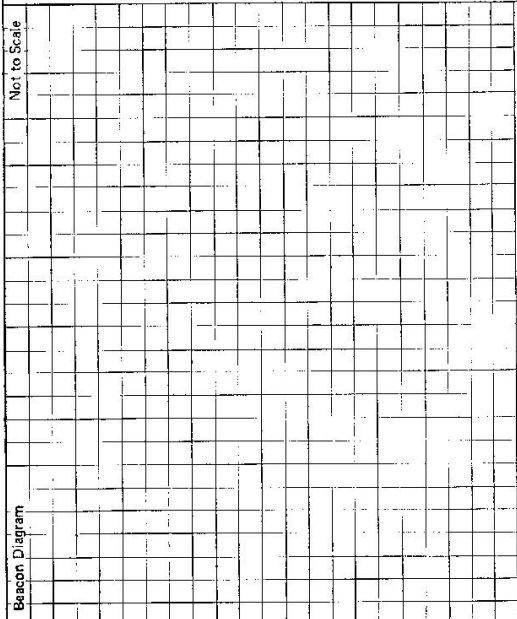
<p>STATION <b>JONDAR YAN IS 2635</b></p>	<p>Owner's Name: <i>Poncah Puc Museum</i>                  Address: <i>CARANGAS</i>                  Phone: .....</p> <p>Current Occupant: .....</p> <p>Address: .....</p> <p>Phone: .....</p> <p style="text-align: center;"><b>ACCESS</b></p> <p>Access Report of <i>17/19/22</i> was found suitable/<del>unsuitable</del>.  <i>MADANDEKA 1.250,000 Map Reference</i>  <i>406/767</i></p> <p><i>Clearing required outside fence and on eastern side of road required to clear lanes to TUOHY x ULONG gadehe stations. Clearing is required within the Museum grounds for McPherson, Maroo's Ballingall gadehe stations. TK Tower at BINGAR I.S is clearly visible.</i></p>
<p>Beacon Diagram</p> <p style="text-align: right;">Not to Scale</p> 	<p>This section to be completed by officer constructing pillar.</p> <p>Original station mark found/not found.</p> <p>Description of mark: .....</p> <p>Original beacon found/not found.</p> <p>Description of beacon: .....</p> <p>Height Top of Vanes to Top Mark.....m.</p> <p>Height of mark.....m. <span style="margin-left: 20px;">above</span> <span style="margin-left: 20px;">below</span> G.L.</p> <p style="margin-left: 20px;">rocks/conc.....m.</p> <p>Diameter of Vanes.....m. <span style="margin-left: 20px;">Height of Cairn.....m.</span></p> <p>Original Beacon has/has not been destroyed by me.</p>
<p>Date</p>	<p>Record of Station</p>

CENTRAL MAPPING AUTHORITY  
 GEODETIC SURVEY OF NSW  
 1541  
 GEODETIC STATION RECONNAISSANCE and MAINTENANCE REPORT

Description:

1. Cleared by lanes bearing 106° 40' 00" M. to Benda. S. 15° 15' 00" M. McPherson. 210.230 from Trig. Mast
2. Mast & Vanes have been painted white & black respectively.
3. The station/pillar was ~~re-established~~ <sup>re-established</sup> /constructed ~~on~~ <sup>on</sup> ~~the~~ <sup>the</sup> ~~site~~ <sup>site</sup> by ~~McPherson~~ <sup>McPherson</sup> on 19.12.1978, dimensions now being: <sup>by McPherson</sup>  
 Description of mark ~~S.I. Pole~~ <sup>S.I. Pole</sup> should be explicit. e.g., S/Steel Pillar Plate, Steel plug, Brass plug, Bolt, G.I. Pipe  
 Height of mark ..... m. <sup>above</sup> / <sup>below</sup> rock/concrete; Mark is 2.55 m. <sup>above</sup> G.L.  
 Height of Top Vanes to ~~Top~~ <sup>Top</sup> Mark/Pillar plate ..... 0.7 ..... m. Diameter of Vanes (vertical) ..... 0.75 ..... m.  
 Height of Cairn ..... m. Diameter of Cairn ..... m. Name Plate found/not found/placed.  
 Length of Mast ..... m. (approximate if not unipled)
4. A. ~~Copper Nail~~ ..... set in conc/rock has been ~~placed~~ <sup>placed</sup> /found, bearing ..... 75 ..... ° M from Mast/Plug/Pillar
5. A. ~~C.I. Pipe~~ ..... set in conc/rock has been ~~placed~~ <sup>placed</sup> /found, bearing ..... 205 ..... ° M from Mast/Plug/Pillar
6. A. .... set in conc/rock has been placed /found, bearing ..... ° M from Mast/Plug/Pillar
7. A. .... set in conc/rock has been placed /found, bearing ..... ° M from Mast/Plug/Pillar
8. Action required: .....

STATION: JONDARYAN GS No: 2635  
 MAP SHEET SCALE 1:250 000 Narrandera.  
 INSPECTED BY: A.Woodruff DATE: 16.9.1978  
 AUTHORITY: C.M.R. FIELD BOOK: 318 STI 189

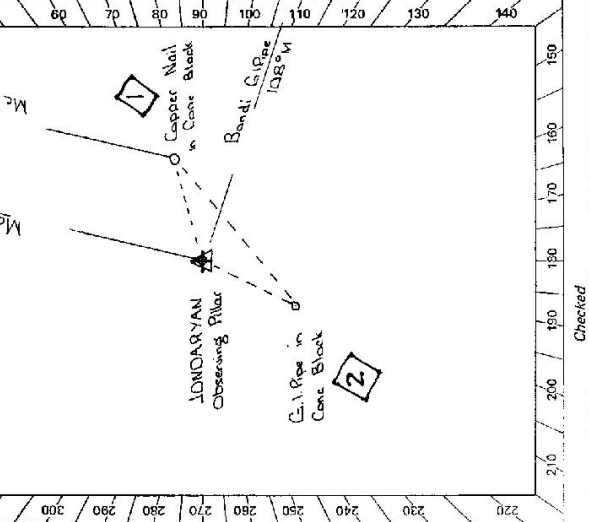

Mark	Direction	Horiz. Distance	Height Difference	Mark	Direction	Horiz. Distance	Height Difference
Benda G.I. Pipe in Conc	0 00 00		above standpt.	McPherson G.S.	0 00 00		above standpt.
McPherson G.S.	263 05 44		above standpt.	G.I. Pipe in Conc Block	217 00 10	7.915	0.005 below standpt.
G.I. Pipe in Conc Block	94 16	4.405	2.324 below standpt.	Jondaryan Obs. Pillar	242 31 40	4.446	above standpt.
Copper Nail in Conc Block	375 35	4.446	above standpt.				above standpt.
			below standpt.				below standpt.
			below standpt.				below standpt.
			below standpt.				below standpt.

STANDPOINT: Observing Pillar (Plate)      STANDPOINT: Copper Nail

Prepared by: A.Woodruff      Checked: *R. S. G. 13.12.78*      Noted on U.I.M. Card

Station Diagram  
 320 330 340 350 360 370 380 390 400  
 North  
 12° M  
 McPherson  
 JONDARYAN Observing Pillar  
 G.I. Pipe in Conc Block  
 Benda G.I. Pipe 106° 40' 00" M  
 Copper Nail in Conc Block  
 210 220 230 240 250 260 270 280 290 300 310 320  
 140 150 160 170 180 190 200 210 220  
 Checked

8c 2733-2 D. West, Government Printer

STATION **JONDARYAN G.S. 2635** TS


Owner's Name: .....  
 Address: .....  
 Phone: .....  
 Current Occupant: .....  
 Address: .....  
 Phone: .....

ACCESS

Access Report of 16/9/1988 was found suitable/unavailable.

Jondaryan G.S. is within the boundaries of the Griffith Pioneer Park Museum, Scenic Hill Remembrance Drive-way Griffith.

Telephone 62 4196

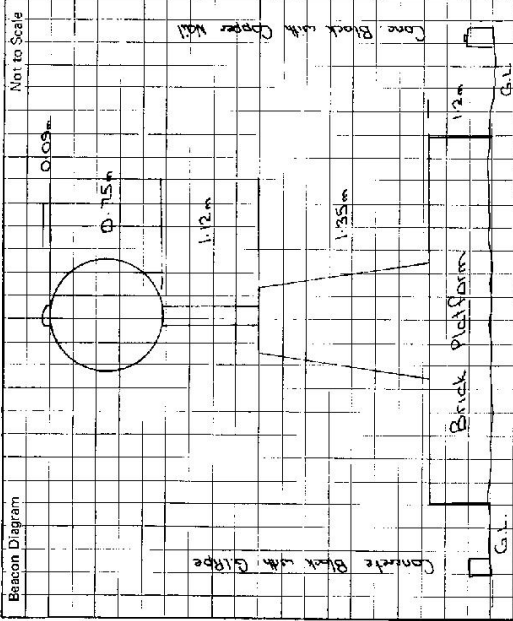

This section to be completed by officer constructing pillar.

Original station mark  found /  not found

Description of mark: .....

Original beacon  found /  not found.

Description of beacon: .....

Height Top of Vane to Top Mark .....m.

Height of mark .....m. above rock/cone .....m. above G.L. below .....m.

Diameter of Vane .....m. Height of Cairn .....m.

Original Beacon has/has not been destroyed by me.

Date	Record of Station

GEODETIC SURVEY OF NS&K

CENTRAL MAPPING AUTHORITY

GEODETIC STATION RECONNAISSANCE and MAINTENANCE REPORT

Description:

1. Cleared by lanes bearing. *No CLAIMS, Vision, Station, from Trig. Mast*  
*No OBSTRUCTIONS FOR SATELLITE SURVEY FROM THIS STATION.*
2. Mast & Vanes have been painted white & black respectively.
3. The station/pillar was ~~unaffected~~ *UNPUNCTURED* on 20.7.1990, dimensions now being:

Description of mark: *Steel Pillar* should be explicit, e.g., S/Steel Pillar Plate, Steel plug, Brass plug, Bolt, G.I. Pipe

Height of mark: *1.34* m. above ~~rock~~ *rock/concrete*; Mark is *2.54* m. above G.L.

Height of Top Vanes to Top Mark/Pillar plate: *1.87* m. Diameter of Vanes (vertical): *15* m.

Height of Cairn: *1.96* m. Diameter of Cairn: *1.96* m. Name Plate found/~~not found~~/placed.

Length of Mast: *1.96* m. (*approximate if not measured*)

4. A. ~~Cement~~ *Block above* ~~rock~~ *Block above* set in conc/~~rock~~ *Block above* found, bearing: *75* °M from ~~Mast/Flag~~ *Mast/Flag* Pillar
5. A. ~~G.I. Pipe~~ *Block above* set in conc/~~rock~~ *Block above* found, bearing: *205* °M from ~~Mast/Flag~~ *Mast/Flag* Pillar
6. A. ~~Block above~~ *Block above* set in conc/~~rock~~ *Block above* has been placed/found, bearing: *195* °M from Mast/Plug/Pillar
7. A. ~~Block above~~ *Block above* set in conc/~~rock~~ *Block above* has been placed/found, bearing: *195* °M from Mast/Plug/Pillar


8. Action required: *Place Two More Recovery Marks and Connection to Check Future*  
*MOVEMENT IF any of STATION.*

STANDPOINT:

Mark	Direction	Horiz. Distance	Height Difference	Mark	Direction	Horiz. Distance	Height Difference
			above standpt				above standpt
			below standpt				below standpt
			above standpt				above standpt
			below standpt				below standpt
Prepared by: *D. KAIN* Checked by: *[Signature]* *Checked by: [Signature]*

*Noted on U.I.M. Cairn*

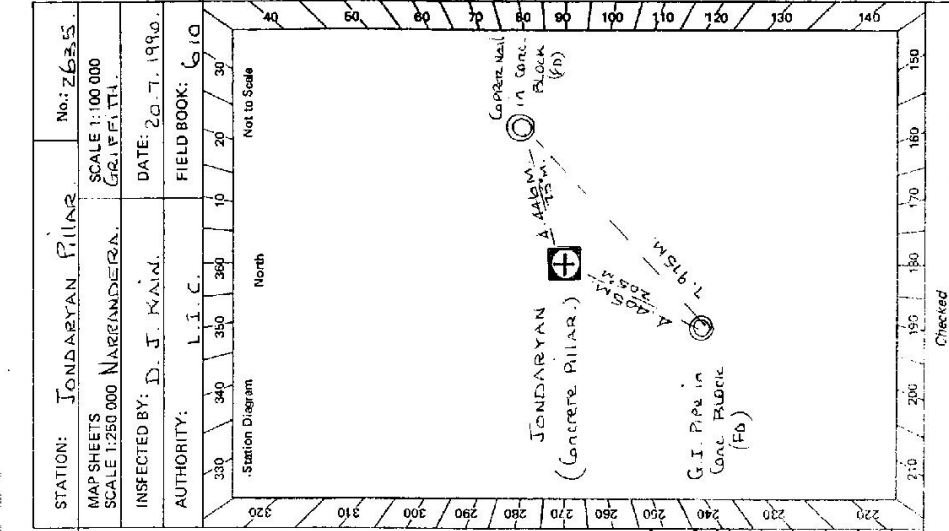

CS 24

STATION SONDARYAN PILLAR IS 2635

Owner's Name PIONEER PARK MUSEUM Current Occupant: .....

Address SCENIC HILL Address: .....

REMEMBERANCE DRIVEWAY, GRIFFITH Phone: .....

Phone: (069) 624 196 ACCESS: .....

Access Report of 20/7/19% was found suitable/unsuitable.

SONDARYAN PILLAR IS WITHIN THE BOUNDARIES OF THE GRIFFITH PIONEER PARK MUSEUM, SCENIC HILL, REMEMBERANCE DRIVEWAY, GRIFFITH.

ACCESS KEY TO LOCKED GATE IS REQUIRED AND IS AVAILABLE FROM, DIRECTOR, MR. PERRY HOWARD? Phone: .....

OR - SECOND IN CHARGE, MR. DARRELL COLLINS (069) 624196

Beacon Diagram: 6.7m Not to Scale

1.81m  
0.75m  
1.12m  
2.14m  
1.2m  
CONCRETE AND BRICK PLAT FORM  
NOTE: THERE ARE OBVIOUS CRACKS IN CONC/BRICK PLATFORM AT THIS STATION.

This section to be completed by officer constructing pillar.

Original station mark found/not found. ....

Description of mark: .....

Original beacon found/not found. ....

Description of beacon: .....

Height Top of Vanes to Top Mark.....m.

Height of mark.....m. above G.L. below

Diameter of Vanes .....m. Height of Cairn .....m.

Original Beacon has/has not been destroyed by me. ....

Date	Record of Station

9-2723-2 0. Maps Government Printer

Batch 1541

LAND INFORMATION CENTRE

GEODETIC SURVEY OF A.S.M.

GEODETIC STATION RECONNAISSANCE and MAINTENANCE REPORT

STATION: JONDARYAN (P) No: 2635

MAP SHEET SCALE 1:250 000

NARRANDERA

INSPECTED BY: J. BICKETS DATE: 1993

AUTHORITY: AUSLIG FIELD BOOK: -

Description: Note: Cross out word or words which do not apply

- Cleared by lanes bearing..... from Trig. Mast
- Mast & Vanes have been painted white & black respectively.
- The station/pillar was unspiled/not unspiled/constructed on..... 19..... dimensions now being:
  - Description of mark..... should be explicit, e.g., S/Steel Pillar Plate, Steel plug, Brass plug, Bolt, G.L. Pipe
  - Height of mark.....m. above rock/concrete; Mark is.....m. above G.L.
  - Height of Top Vanes to Top Mark/Pillar plate.....m. Diameter of Vanes (vertical!).....m.
  - Height of Cairn.....m. Diameter of Cairn.....m. Name Plate found/not found/placed.
  - Length of Mast.....m. (approximate if not unspiled)
- A. Cu. Nail.....set in conc/~~rock~~ has been placed/found, bearing.....°M from Mast/Plug/Pillar
- A. G.L. Pipe.....set in conc/~~rock~~ has been placed/found, bearing.....°M from Mast/Plug/Pillar
- A. Dumpy.....set in conc/rock has been placed/found, bearing.....°M from Mast/Plug/Pillar
- A.....set in conc/rock has been placed/found, bearing.....°M from Mast/Plug/Pillar

8. Action required:.....

Mark	Direction	Horiz. Distance	Height Difference	Mark	Direction	Horiz. Distance	Height Difference
McPherson (3036)	0 00 00			Chowncy TS 10884	0 00 00		
Chowncy TS 10884	41 03 02			Whitten (P) 2866	98 33 02		
Dumpy	44 25 20	5.820		Cu. Nail	142 18 39	2.095	
Cu. Nail	62 26 25	4.455	2.319	(P)	183 23 51	5.820	
G.L. Pipe	191 11 06	4.400	2.324				

STANDPOINT: Jondaryan (P) STANDPOINT: Dumpy

Prepared by: AJ

Checked: Noted on U.T.M. Card

Checked

