

LAND INFORMATION CENTRE

GEODETIC SURVEY OF N.S.W.

GEODETIC STATION RECONNAISSANCE and MAINTENANCE REPORT

Description:

1. Cleared by lanes bearing **0°M - 215°M, 220°M - 360°M** from T'ing Mast
Note: Cross out word or words which do not apply
2. ~~Mast & Vanes have been painted white & black respectively.~~
found
3. The station/~~pillar~~ was unplied/~~re-established~~ on **9th Feb 1998**, dimensions now being:

Description of mark **RASC** ~~Plygue~~ could be explicit, e.g., S/Steel Pillar Plate, Steel plug, Brass plug, Bolt, G.I. Pipe
 Height of mark: — m. above rock/concrete; Mark is — m. above G.L.
 Height of Top Vanes to Top Mark/Pillar plate — m. Diameter of Vanes (vertical) E398 m.
 Height of Cairn — m. Diameter of Cairn — m. Name Plate found/~~not found~~/placed.

Length of Mast — m. (approximate if not unplied)

4. A. **RM 1** set in conc/reek has been ~~placed~~/found, bearing **40°** M from ~~the pillar~~ **Plygue**
5. A. **RM 2** set in conc/reek has been ~~placed~~/found, bearing **111°** M from ~~the pillar~~ **Plygue**
6. **Blazed Tree** ~~set in conc/reek~~ has been ~~placed~~/found, bearing **218°** M from ~~the pillar~~ **Plygue**
7. A. ~~set in conc/reek~~ has been placed/round, bearing N/S M from Mast/Plug/Pillar
8. Action required: N/S


STANDPOINT: _____

Mark	Direction	Horiz. Distance	Height Difference	Mark	Direction	Horiz. Distance	Height Difference
			above standpt.				above standpt.
			below standpt.				below standpt.
			above standpt.				above standpt.
			below standpt.				below standpt.
Prepared by: J. Webb 17.2.98 Checked: E. Webb

Noted on U.T.M. Card

Checked

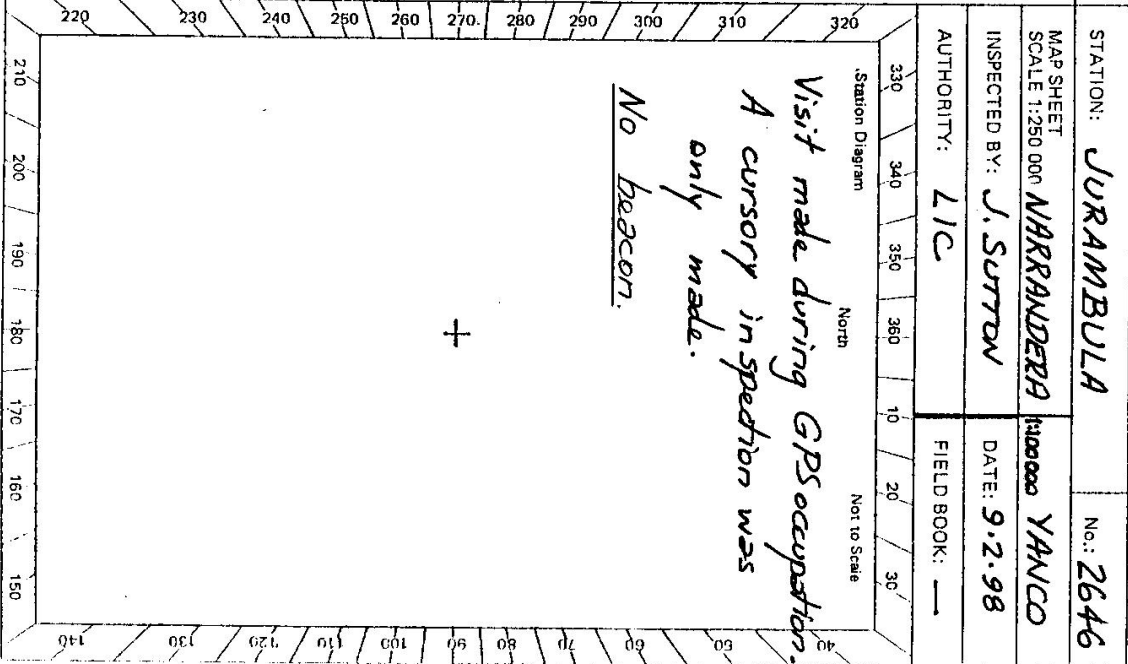

STATION **JURAMBULA 2646**

Beacon Diagram	Not to Scale
<p>This section to be completed by officer constructing pillar.</p> <p>Original station mark found at location</p> <p>Description of mark:</p> <p>Original beacon found/not found:</p> <p>Description of beacon:</p> <p>Height Top of Vanes to Top Markm.</p> <p>Height of mark:m. above rock/concm. above G.L.</p> <p style="margin-left: 20px;">below</p> <p>Diameter of Vanesm. Height of Cairnm.</p> <p>Original Beacon has/has not been destroyed by me.</p>	

<p>Access Report of ^{kms}...../1965 was found at location</p> <p>0.00 At Bridge at Narrandera over Murrumbidgee River heading for Hay.</p> <p>0.85 At Newell Highway/Start Highway intersection head for Hay & Jerilderie.</p> <p>1.65 At Hay/Jerilderie intersection travel towards Hay.</p> <p>1.95 Travel over bridge on Yaraco Creek.</p> <p>31.60 Turnoff to left to access owners house.</p> <p>35.65 Turn into double iron gates on left. (LOCKED)</p> <p>36.25 Through single iron gate.</p> <p>36.85 Through double iron gates.</p> <p>37.45 Through double iron gates.</p> <p>37.90 Signpost 'Bamandra State forest'. Through single iron gate.</p> <p>39.15 Immediately before single iron gate turn left along faint track on Northern side of fence line.</p> <p>40.50 Turn & head north from fence line.</p> <p>40.55 Jurambula Δ near blazed mallee tree on end of low sandy ridge.</p> <p>Access is suitable for conventional drive vehicle to BDM from trig (sandy).</p>	<p>Access Owner's Name: John Gillard</p> <p>Address: Tubbo Irrigation Start Highway Via Narrandera</p> <p>Phone:</p> <p>Current Occupant:</p> <p>Address:</p> <p>Phone:</p> <p style="text-align: center;">ACCESS</p>
Record of Station	
Date	Date
9-2-98	