

CENTRAL MAPPING AUTHORITY
Department of Lands

Trigonometrical Survey of N.S.W.

RECONNAISSANCE and MAINTENANCE REPORT

This Trig. Station has been:-

Note: Cross out word or words which do not apply

1. Completely cleared to permit 360° vision to surrounding Trigs.
2. Cleared by lanes bearing..... from Trig. Mast
3. Trig. Mast & Vanes have been painted white & black respectively.
4. The Trig. was unpiled/not unpiled, dimensions now being: Original Station

Description of mark..... should be explicit, e.g. Steel plug, Brass plug, Bolt, G.I. Pipe

Height of mark..... m above below rock/concrete..... m above below G.L.

Height of Top Vanes to Top Mark..... m. Diameter of Vanes (vertical)..... m.

Height of Cairn..... m. Diameter of Cairn..... m.

Length of Mast..... m. (approximate if not unpiled)

5. A..... set in conc/rock has been placed..... m. bearing..... °M from Trig. Mast
6. A..... set in conc/soil has been placed..... m. bearing..... °M from Trig. Mast
7. A..... set in conc/soil has been placed..... m. bearing..... °M from Trig. Mast
8. A..... set in conc/rock has been placed..... m. bearing..... °M from Trig. Mast

9. Connection..... to..... m. bearing..... °M
10. Connection..... to..... m. bearing..... °M
11. Connection..... to..... m. bearing..... °M
12. Connection..... to..... m. bearing..... °M

13. Diff. Ht. is..... m. above below
14. Diff. Ht. is..... m. above below
15. Diff. Ht. is..... m. above below
16. Diff. Ht. is..... m. above below

Prepared by: *[Signature]* 21/4/70


Checked: *[Signature]*

Noted on U.T.M. Card

STATION JUJENILLE TS 2647

Co: CROCIANA PH: GRSVENAND
Map Sheet: AS-50-80-10-11 No: 5730 1111/1
Inspected by: N MORTON Date: NOVEMBER 1976
Authority: Field Book: Net to Scale

Beacon Diagram

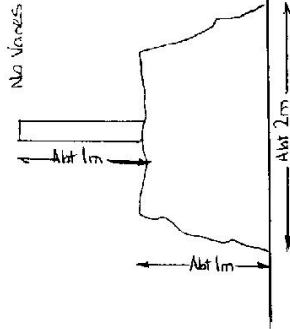

Date	Record of Station

Checked

GEODETTIC SURVEY OF N.S.W.

CENTRAL MAPPING AUTHORITY

GEODETTIC STATION RECONNAISSANCE and MAINTENANCE REPORT

STATION: **JUVENILE** No.: **2647**

MAP SHEET SCALE 1:250 000 **BATHURST**

INSPECTED BY: **A GARSIDIE** DATE: **13-8-81**

AUTHORITY: **C.M.A.** FIELD BOOK: **1986**

- Description:
- Cleared by lanes bearing..... **3.6 C**.....
Note: Cross out word or words which do not apply
 from Trig. Mast
 - Mast & Vanes have been painted white & black respectively.
 - The station/~~pillar~~ ~~was~~ ~~upplied~~ ~~hot~~ ~~unplied~~ ~~constructed~~ on..... **13-8-81**.....
 dimensions now being:
 Description of mark..... should be explicit, e.g., S/Steel Pillar Plate, Steel plug, Brass plug, Bolt, G.I. Pipe
 Height of mark..... m. ^{above} _{below} rock/concrete; Mark is..... m. ^{above} _{below} G.I.
 Height of Top Vanes to Top Mark/Pillar plate..... m. Diameter of Vanes (vertical)..... m. **AC VANES**
 Height of Cairn..... m. Diameter of Cairn..... m. Name Plate found/not found/placed.
 Length of Mast..... m. (approximate if not unplied)
 - A..... set in conc/rock has been placed/found, bearing..... M from Mast/Plug/Pillar
 - A..... set in conc/rock has been placed/found, bearing..... M from Mast/Plug/Pillar
 - A..... set in conc/rock has been placed/found, bearing..... M from Mast/Plug/Pillar
 - A..... set in conc/rock has been placed/found, bearing..... M from Mast/Plug/Pillar
 - Action required: **D.M. TO CONSTRUCT PILLAR STATION IN CONC. CASE, I.E. R.P.P.**

STANDPOINT:

Mark	Direction	Horiz. Distance	Height Difference	Mark	Direction	Horiz. Distance	Height Difference
			above standpt.				above standpt.
			below standpt.				below standpt.
			above standpt.				above standpt.
			below standpt.				below standpt.
Prepared by: *[Signature]* 15/10/81

Checked: *[Signature]*

Noted on U.T.M. Card

