

CENTRAL MAPPING AUTHORITY

GEODETIC SURVEY OF N.S.W.

GEODETIC STATION RECONNAISSANCE and MAINTENANCE REPORT

Description:

1. Cleared by lanes bearing $53^{\circ} 16' 55''$ 146.5 m, $97^{\circ} 08'$ 146.5 m, $153^{\circ} 156''$ 200 m, $202^{\circ} 24'$ 240 m, $240^{\circ} 24'$ 240 m, $269^{\circ} 27'$ 275 m, $339^{\circ} 34'$ 270 m. Mast & Vanes have been painted white & black respectively.
2. Mast & Vanes have been painted white & black respectively.
3. The station/pillar was unpiled/~~not~~ ~~replaced~~/~~constructed~~ on 22° $19.89'$, dimensions now being: Description of mark ~~Base~~ ~~stone~~ ~~fin~~ should be explicit, e.g., S/Steel Pillar Plate, Steel plug, Brass plug, Bolt, G.I. Pipe

Note: Cross out word or words which do not apply

Height of mark 0.05 m ^{above rock/concrete} Mark is AT m ^{above G.L.} 1.21 m.
 Height of Top Vanes to Top Mark/~~Plate~~ 3.97 m. Diameter of Vanes (vertical) 0.91 m.
 Height of Cairn 1.25 m. Diameter of Cairn 2.5 m. Name Plate ~~found~~/~~not found~~/~~placed~~.
 Length of Mast 3.97 m. (~~approximate if not stipulated~~)

4. A.....set in conc/rock has been placed/found, bearing.....° M from Mast/Plug/Pillar
5. A.....set in conc/rock has been placed/found, bearing.....° M from Mast/Plug/Pillar
6. A.....set in conc/rock has been placed/found, bearing.....° M from Mast/Plug/Pillar
7. A.....set in conc/rock has been placed/found, bearing.....° M from Mast/Plug/Pillar

8. Action required: ~~CAIRN TO BE REPLACED~~.....MAST NEEDS REPLACING.....

STANDPOINT:

Mark	Direction	Horiz. Distance	Height Difference	Mark	Direction	Horiz. Distance	Height Difference
			above standpt				above standpt
			below standpt				below standpt
			above standpt				above standpt
			below standpt				below standpt
Prepared by: D. Kain. Checked: J. Hill. Noted on U.T.M. Card

ST 2738-1

STATION: KADINA G.S. No.: 2650
 MAPSHEET SCALE 1:250 000 NARROMINE
 INSPECTED BY: D. J. KAIN DATE: 19.10.89
 AUTHORITY: L.I.C. FIELD BOOK: 443 N.D. 2487

Station Diagram

Not to Scale

Concrete E.C.C.C. Pillar

Brass fin

Station was visited for purpose of clearing sight lanes for forthcoming G.P.S. survey


STATION **KADINA G.S. IS 2650**

Owner's Name: **MRS. RESERVE NO: 35743** & Current Occupant: **M.R. NORMAN, MATT.**
 Address: **Allambié**
 Phone: **(068) 65 3249**

ACCESS M-10-1984

Previous Report of.../19...was found ~~unsuitable~~/unsuitable. FEATURE.

- 0.00 AT NEW BRICK HOUSE *ALLAMBIÉ HOMESTEAD TRAVEL SOUTHERLY
- 0.17 ALONG TRACK TOWARDS OLD HOMESTEAD
- 0.30 TURN OFF TRACK TO YOUR LEFT AND AROUND BOTTOM OF DAM WALL,
- 0.35 (AROUND BACK OF OLD PARKED TRUCK)
- 0.52 THROUGH DOUBLE IRON GATES, FOLLOW TRACK.
- 0.64 THROUGH OPENING IN LINE OF OLD FENCE POSTS FOLLOW TRACK UP ONTO
- 1.31 PASS DAM ON YOUR R.H.S., FOLLOW TRACK. SMALL RISE.
- 1.69 THROUGH DOUBLE IRON GATES ON YOUR L.H.S. THEN TURN RIGHT AND FOLLOW
- 1.95 THROUGH DOUBLE IRON GATES AND FOLLOW TRACK ALONG SOUTHERN
- 2.05 THROUGH DOUBLE IRON GATES AND KEEP FOLLOWING TRACK ALONG SOUTHERN
- 2.36 THROUGH DOUBLE IRON GATES AND KEEP FOLLOWING TRACK ALONG SOUTHERN
- 2.39 THROUGH DOUBLE IRON GATES AND KEEP FOLLOWING TRACK ALONG SOUTHERN
- 3.58 AT RILES OF OLD SAWN TIMBER AND LOGS ON YOUR L.H.S. TURN
- 6.07 CROSSING FOLLOW TRACK ALONG NORTHERN SIDE OF CREEK.

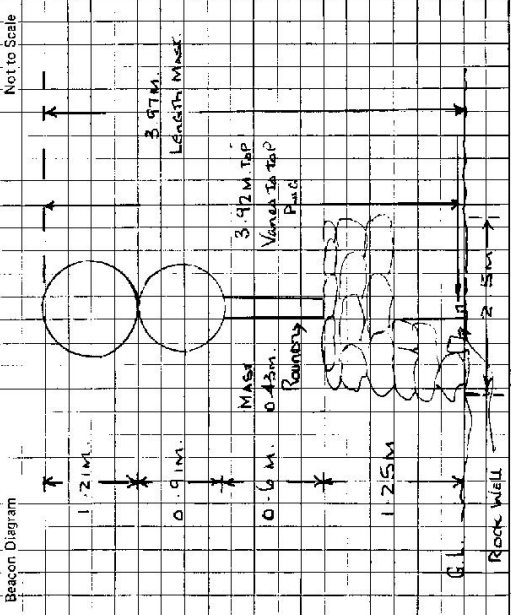

This section to be completed by officer constructing pillar.

Original station mark found/~~not found~~.

Description of mark: **BRONZE PILE**

Original beacon found/~~not found~~.

Description of beacon: **Pole Cairn & Discs**

Height Top of Vanes to Top Mark.....m.

Height of mark.....m above G.L. below

Diameter of Vanes.....m. Height of Cairn.....m.

Original Beacon ~~has~~/has not been destroyed by me.

Record of Station

Date