

CENTRAL MAPPING AUTHORITY
Department of Lands

Trigonometric (alt. Survey of N.S.W.


RECONNAISSANCE and MAINTENANCE REPORT

This Trig. Station has been:-

Note: Cross out word or words which do not apply

1. ~~Completely cleared to permit 360° vision to surrounding Trigs.~~
2. Cleared by lances bearing ~~265° to 30°~~ ~~80° to 90°~~ from Trig. Mast
3. Trig. Mast & Vanes have been painted white & black respectively.
4. The Trig. was ~~erected~~/not unplied, dimensions now being:
 - Description of mark..... should be explicit, e.g. Steel plug, Brass plug, Bolt, G.L. Pipe
 - Height of mark..... m above rock/concrete..... m below G.L.
 - Height of Top Vanes to Top Mark..... m. Diameter of Vanes (vertical) ~~1.01~~..... m.
 - Height of Cairn ~~1.02~~..... m. Diameter of Cairn ~~1.50~~..... m.
 - Length of Mast ~~3.21~~..... m. (approximate if not unplied)


5. A..... set in conc/rock has been placed..... m. bearing..... °M from Trig. Mast
6. A..... set in conc./soil has been placed..... m. bearing..... °M from Trig. Mast
7. A..... set in conc./soil has been placed..... m. bearing..... °M from Trig. Mast
8. A..... set in conc/rock has been placed..... m. bearing..... °M from Trig. Mast
9. Connection..... to..... m. bearing..... °M
10. Connection..... to..... m. bearing..... °M
11. Connection..... to..... m. bearing..... °M
12. Connection..... to..... m. bearing..... °M
13. Diff. Ht. is..... m. above below
14. Diff. Ht. is..... m. above below
15. Diff. Ht. is..... m. above below
16. Diff. Ht. is..... m. above below

Prepared by:  Checked: _____

Noted on U.T.M. Card

STATION KALYARA | Ph: WARD | TS 2653
 Co: HAWES
 Map Sheet: UPPER MANNING | No: 9234
 Inspected by: M.L. Morrison | Date: 12.7.77
 Authority: _____ | Field Book: 1580

Beacon Diagram
Net to Scale

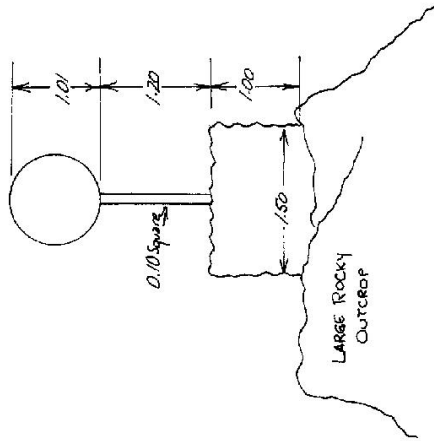

Date _____ Record of Station

Trig. Sta. to 882 - Abt 1 day clearing required
 " 902 to 265 - Heavy Timber tall heavy high
 from TS. No OTHER MARKS.
ALL MARKERS LARGE MANNING SYSTEM, 1960 OR 1961. 1960/1961.
ALL SYSTEM.

Checked

