

CENTRAL MAPPING AUTHORITY

GEODETIC STATION RECONNAISSANCE and MAINTENANCE REPORT


STATION: **KANGAROO VALLEY** No.: **2659**

MAP SHEET SCALE 1:250 000 **Wollongong**

INSPECTED BY: **A. Sivertsen** DATE: **12-1-79**

AUTHORITY: **CMA** FIELD BOOK: **1723**

- Description:
1. Cleared by lances bearing..... **Timbered 360** from Trig. Mast
 2. Mast & Vanes have been painted white & black respectively.
 3. The station/pillar was unpiled/not unpiled/constructed on..... 19....., dimensions not being:
Description of mark..... should be explicit, e.g., S/Steel Pillar Plate, Steel plug, Brass plug, Bolt, G.I. Pipe
Height of mark..... m. ^{above} _{below} rock/concrete; Mark is..... m. ^{above} _{below} G.L.
 4. A..... set in conc/rock has been placed/ found, bearing..... ° M from Mast/Plug/Pillar
 5. A..... set in conc/rock has been placed/ found, bearing..... ° M from Mast/Plug/Pillar
 6. A..... set in conc/rock has been placed/ found, bearing..... ° M from Mast/Plug/Pillar
 7. A..... set in conc/rock has been placed/ found, bearing..... ° M from Mast/Plug/Pillar
 8. Action required:.....

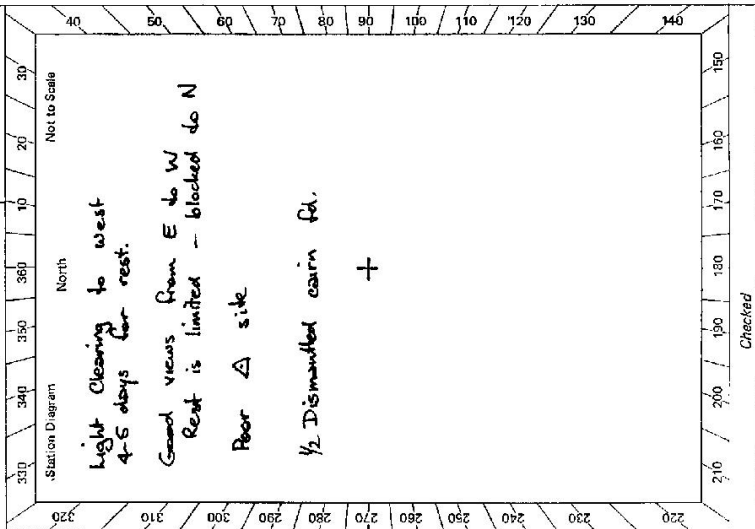


STANDPOINT: **KANGAROO VALLEY**
1: 25 000

Mark	Direction	Horiz. Distance	Height Difference	Mark	Direction	Horiz. Distance	Height Difference
			above below				above standpt. below
			above standpt. below				above standpt. below
			above standpt. below				above standpt. below
Prepared by: *[Signature]* 23/1
Checked: *[Signature]*
Noted on U.T.M. Card

81 2733-2 D. West, Government Printer

STATION **KANGAROO VALLEY TS 2659**

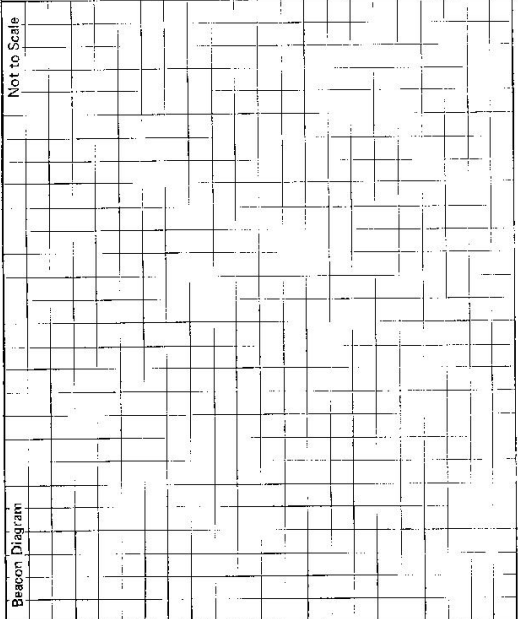

Owner's Name:
 Address:
 Phone:
 Current Occupant:
 Address:
 Phone:

ACCESS

Access Report of 12/1/1978 was found suitable/unsuitable.

km
 0-8 KANGAROO VALLEY PO. Head towards MOSS VALE
 2-4 Turn R up UPPER KANG. VALL. ROAD
 12-3 Pass hall of footbridge
 12-6 Straight ahead where main road turns right
 12-8 " " " track " "
 15-1 Pass track on R
 15-5 Gate
 15-7 House of gate. CALL IN
 16-0 T intersection. Turn R
 16-5 Gate
 17-0 Gate
 17-2 Take main fork to R
 17-6 Gate of Shed
 17-9 Pass track on R
 18-4 Where track turns L down hill go straight ahead
 18-5 Fence. 35 mins easy walk along centre of ridge,
 across saddle to A. Plenty of string nettles

This section to be completed by officer constructing pillar.

Original station mark found/not found.

Description of mark:

Original beacon found/not found.

Description of beacon:

Height Top of Vane to Top Markm.

Height of markm. above G.L.
 below

Diameter of Vanem. Height of Cairnm.

Original Beacon has/has not been destroyed by me.

Date	Sign of Station