

CENTRAL MAPPING AUTHORITY

GEODETIC SURVEY OF N.S.W.

GEODETIC STATION RECONNAISSANCE and MAINTENANCE REPORT

Description:

1. Cleared by lanes bearing 56° *BALD HILL* from Trig. Mast

2. Mast & Vanes have been painted white & black respectively. ✓

3. The station/pillar was ~~used~~ *USED* on 19.86 , dimensions now being:

Description of mark: *PLUG. PLATE* should be explicit, e.g., S/Steel Pillar Plate, Steel plug, Brass plug, Bolt, G.I. Pipe

Height of mark: 1.150 m. ^{above} *1.410* m. _{below} Mark is *1.410* m. ^{above} *1.410* m. _{below} Diameter of Vanes (vertical) 0.250 m.

Height of Top Vanes to Top Mark/Pillar plate 1.440 m. Diameter of Cairn 0.100 m. Name Plate found/~~not found~~/placed.

Height of Cairn 0.100 m. Diameter of Cairn 0.100 m. Name Plate found/~~not found~~/placed.

Length of Mast 0.100 m. (approximate if not unplied)

4. A 0.100 set in conc/rock has been placed/found, bearing 0° M from Mast/Plug/Pillar

5. A 0.100 set in conc/rock has been placed/found, bearing 0° M from Mast/Plug/Pillar

6. A 0.100 set in conc/rock has been placed/found, bearing 0° M from Mast/Plug/Pillar

7. A 0.100 set in conc/rock has been placed/found, bearing 0° M from Mast/Plug/Pillar

8. Action required: 0.100 set in conc/rock has been placed/found, bearing 0° M from Mast/Plug/Pillar

STANDPOINT:

STANDPOINT:

Mark	Direction	Horiz. Distance	Height Difference	Mark	Direction	Horiz. Distance	Height Difference
			above standpt.				above standpt.
			below				below
			above standpt.				above standpt.
			below				below
Prepared by: *J Ford. 19/5/86*

Checked:

Noted on U.T.M. Card *4*

STATION: **KANWARY (P)** No.: **2663**

MAP SHEET SCALE 1:250 000 **NEWCASTLE** 1:15 000 **MARILAND**

INSPECTED BY: **G. FORD** DATE: **14-8-86**

AUTHORITY: **CMA** FIELD BOOK:

Station Diagram

North


Map to Scale

Checked: *P. Brown 6/2/87*

S: 2733 - 2 G. West, Government Printer

STATION

KANIMAY (P) IS 2663

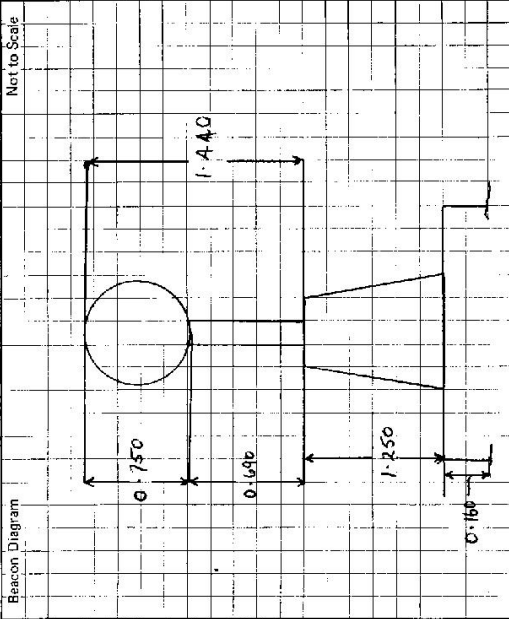

Owner's Name: SEGEREY LANE
 Address: LOT 1 HINTON RD
NEASONS PLAINS
 Phone: 874-377

Current Occupant:
 Address:
 Phone:

ACCESS

Access Report of M. & J. 1986 was found suitable/unsuitable.

FROM EAST MAINLAND FOR ABOUT 3 KM TO THE VILLAGE OF
 MORIETH ON THE HUNTER RIVER AT SIGNPOST 27 CLARENCE TOWN, 2 HINTON
 TAKE THIS SEALED ROAD ACROSS THE HUNTER RIVER
 SIGNPOST 27 CLARENCE TOWN, 3 HINTON
 TAKE SEALED ROAD ON RIGHT SIGNPOST, HINTON 2 CLARENCE TOWN 26
 CROSS BRIDGE OVER PATTERSON RIVER AND TRAVEL STRAIGHT ANGEL ALONG
 MAIN SEALED ROAD
 WATER PIPELINE CLEARLY VISIBLE ON L.H.S. ROAD TO LEFT OVER GRID
 SO JARUS BEYOND PIPELINE [LOT 1 HINTON RD]
 FOLLOW THIS TRACK UP SMALL GRASSY HILL PASSING OWNER'S HOUSE ON RIGHT
 KANIMAY PILLAR AT TOP OF HILL

- C.O 0-32
- 2-58
- 7-33

This section to be completed by officer constructing pillar.

Original station mark found/not found.

Description of mark:

Original beacon found/not found.

Description of beacon:

Height Top of Varies to Top Mark:m.

Height of mark:m. above G.L. / below G.L.

Diameter of Varies:m.

Original Beacon has/has not been destroyed by me.

Date

Record of Station