

GEODETTIC SURVEY OF N.S.W.

CENTRAL MAPPING AUTHORITY

GEODETTIC STATION RECONNAISSANCE and MAINTENANCE REPORT

STATION: **KAOARADA GS (P)** No.: **2664**

MAP SHEET: **HASTINGS**

INSPECTED BY: **P. ROHNER** DATE: **22-2-79**

AUTHORITY: **CMA** FIELD BOOK: **---**

Description: *Note: Cross out word or words which do not apply*

1. Cleared by lanes bearing..... from Trig, Mast
2. Mast & Vanes have been painted white & black respectively.
3. The station/pillar was unpiled/not unpiled/constructed on.....19....., dimensions now being:
Description of mark.....should be explicit, e.g., S/Steel Pillar Plate, Steel plug, Brass plug, Bolt, G.I. Pipe
Height of mark.....m. ^{above} _{below} rock/concrete; Mark is.....m. ^{above} _{below} G.I.L.
Height of Top Vanes to Top Mark/Pillar platem. Diameter of Vanes (vertical).....m.
Height of Cairn.....m. Diameter of Cairn.....m. Name Plate found/not found/placed.
Length of Mast.....m. (approximate if not unpiled)
4. A.....set in conc/rock has been placed/found, bearing.....°M from Mast/Plug/Pillar
5. A.....set in conc/rock has been placed/found, bearing.....°M from Mast/Plug/Pillar
6. A.....set in conc/rock has been placed/found, bearing.....°M from Mast/Plug/Pillar
7. A.....set in conc/rock has been placed/found, bearing.....°M from Mast/Plug/Pillar
8. Action required:.....

STANDPOINT:


Mark	Direction	Horiz. Distance	Height Difference	Mark	Direction	Horiz. Distance	Height Difference
			above standpt. below				above standpt. below
			above standpt. below				above standpt. below
Prepared by:

Checked:

612733-1

Noted on U.T.M. Card

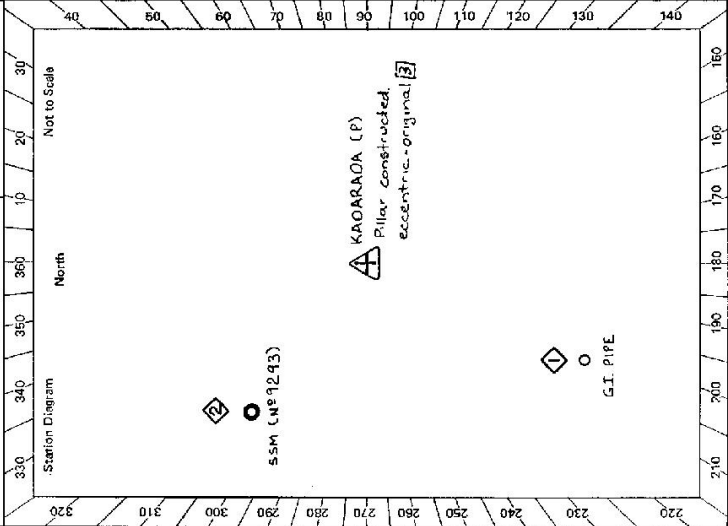

CENTRAL MAPPING AUTHORITY

GEODETIC SURVEY OF N.S.W.

GEODETIC STATION RECONNAISSANCE and MAINTENANCE REPORT

- Description: *Note: Cross out word or words which do not apply*
- Cleared by lanes bearing..... from Trig. Mast
 - Mast & Vanes have been painted white & black respectively.
INVESTIGATED BY: WINSY REFUSED TO BE CONTACTED ON 19/5/22, dimensions now being:
 - The station/pillar was ~~replaced~~ *replaced* on ~~19/5/22~~ *19/5/22*, dimensions now being:
 Description of mark *S/S Pillar* should be explicit, e.g., S/Steel Pillar Plate, Steel plug, Brass plug, Bolt, G.I. Pipe
 Height of mark *1.375* m. above ~~rock/concrete~~ *rock/concrete*; Mark is *AT* m. above G.L.
 Height of Top Vanes to Top ~~Mark/Pillar plate~~ *4.3* m. Diameter of Vanes (vertical) *0.15* m.
 Height of Cairn *0.3* m. Diameter of Cairn *0.3* m. Name Plate found/not found/placed.
 Length of Mast *1.530* m. (~~approximate-if not measured~~)
 - A. *set in conc/rock has been placed/found, bearing.....°M from Mast/Plug/Pillar*
 - A. *set in conc/rock has been placed/found, bearing.....°M from Mast/Plug/Pillar*
 - A. *set in conc/rock has been placed/found, bearing.....°M from Mast/Plug/Pillar*
 - A. *set in conc/rock has been placed/found, bearing.....°M from Mast/Plug/Pillar*
 - Action required:.....

STANDPOINT:

Mark	Direction	Horiz. Distance	Height Difference	Mark	Direction	Horiz. Distance	Height Difference
			above standpt				above standpt
			below				below
			above standpt				above standpt
			below				below
STANDPOINT:

Mark	Direction	Horiz. Distance	Height Difference	Mark	Direction	Horiz. Distance	Height Difference
			above standpt				above standpt
			below				below
			above standpt				above standpt
			below				below
Prepared by: D. KAIN

Checked: *W*

Note on U.T.M. Card

STATION: KANGARUA CONC. PILLAR No. 2664
 MAP SHEETS SCALE 1:250 000 HASTINGS
 INSPECTED BY: D. J. KAIN. DATE: 7. 3. 22
 AUTHORITY: C.M.A. FIELD BOOK: 1457


Station Diagram

Checked: *W*

STATION **KARARAOA Concrete Pillar 2664**

Owner's Name:
 Address:
 Phone:

Current Occupant:
 Address:
 Phone:
ACCESS
 Access Report of/19.....was found suitable/unsuitable.

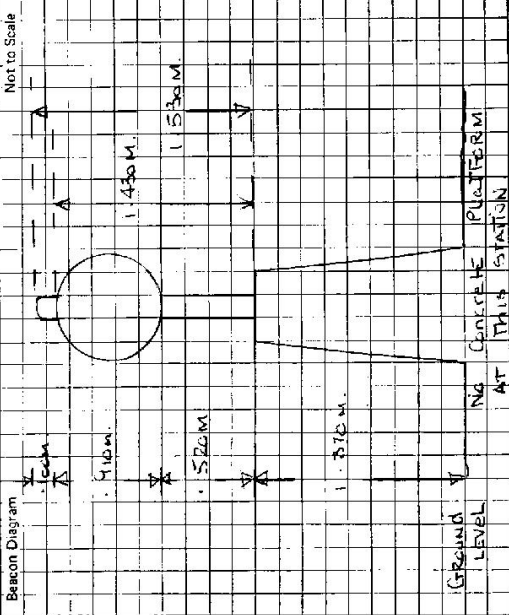

This section to be completed by officer constructing pillar.

Original station mark found/not found.

Description of mark:

Original beacon found/not found.

Description of beacon:

Height Top of Vanes to Top Markm.

Height of markm. above G.L. below

Diameter of Vanesm.

Original Beacon has/has not been destroyed by me.

Date

Record of Station