

CENTRAL MAPPING AUTHORITY

GEODETIC SURVEY OF N.S.W.

GEODETIC STATION RECONNAISSANCE and MAINTENANCE REPORT

Description:

Note: Cross out word or words which do not apply

1. Cleared by lanes bearing... 265°... 126° Mi. 150°... 243° M. .... from Trig. Mast
2. Mast & Vanes have been painted white & black respectively.
3. The station/pillar was ~~replaced~~/not unpiled/assisted on... 3rd March... 19.78... dimensions now being: Description of mark... should be explicit, e.g. S/Steel Pillar Plate, Steel plug, Brass plug, Bolt, G.I. Pipe  
Height of mark... m. above rock/concrete; Mark is... m. above G.L.  
Height of Top Vanes to Top Mark/Pillar plate... m. Diameter of Vanes (vertical) 0.214... m.  
Height of Cairn... 1.0... m. Diameter of Cairn... 1.4... m. Name Plate found/not found/placed.  
Length of Mast... m. (approximate if not unpiled)
4. A... S.S.M. ... set in conc/rock has been placed/found, bearing... 253° M from Mast/~~Plug/Pillar~~
5. A... set in conc/rock has been placed/found, bearing... M from Mast/~~Plug/Pillar~~
6. A... set in conc/rock has been placed/found, bearing... M from Mast/~~Plug/Pillar~~
7. A... set in conc/rock has been placed/found, bearing... M from Mast/~~Plug/Pillar~~  
Painting of Mast & Vanes (connection to Original Mark)
8. Action required: Clearing of 6 trees estimated at 1/2 day.


STANDPOINT: S.S.N. in Concrete found

Mark	Direction	Horiz. Distance	Height Difference	Mark	Direction	Horiz. Distance	Height Difference
Mean Mast (Bottom/Vanes)	84° 56' 56" / 2.818	1.526 above	standpt.				
MOONAN GS	218° 28' 10"		above standpt.				
WALLABY ROCKS GS	243° 49' 55"		above standpt.				
BRUSH HILL GS	251° 52' 25"		above standpt.				
			below standpt.				
			above standpt.				
			below standpt.				
			above standpt.				
			below standpt.				

Prepared by: *Handwritten Signature*

Checked: *Handwritten Signature*

ST-2733-1

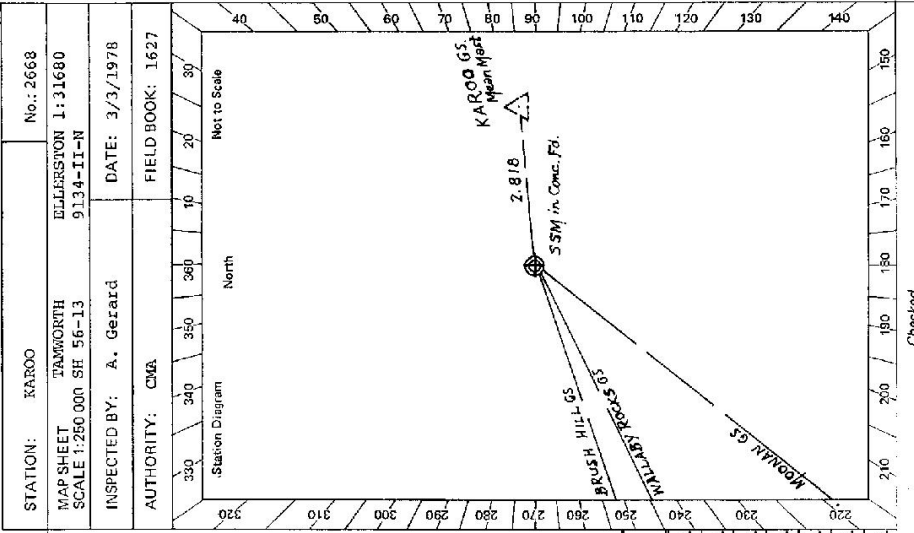

Checked

