

GEODETTIC SURVEY OF N.S.W

CENTRAL MAPPING AUTHORITY


GEODETTIC STATION RECONNAISSANCE and MAINTENANCE REPORT

STATION: KENTHILL No.: 2671

MAP SHEET SCALE 1:250 000 445/2665

INSPECTED BY: L. A. Hoares DATE: 25<sup>th</sup> August 2018

AUTHORITY: C. M. P. FIELD BOOK: 0165

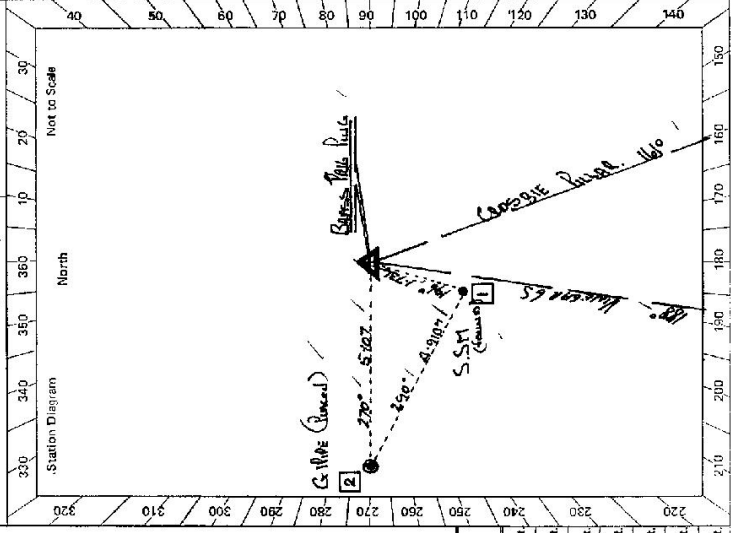

- Description: Note: Cross out word or words which do not apply
- Cleared by lanes bearing 175° 30' 290° from Trig. Mast
  - Mast & Vanes have been painted white & black respectively. ✓
  - The station/pillar was unpiled/~~reconstructed~~/~~constructed on~~ 2.5 m. 19.76. dimensions now being: Description of mark. Brass Plug should be explicit, e.g., S/Steel Pillar Plate, Steel plug, Brass plug, Bolt, G.I. Pipe Height of mark 0.44 m. above rock/concrete: Mark is above m. below G.L. Height of Top Vanes to Top Mark/Pillar plate 3.590 m. Diameter of Vanes (vertical) 6.20 m. Height of Cairn 1.300 m. Diameter of Cairn 1.60 m. Name Plate found/not found/placed. Length of Mast 3.730 m. (~~approximately 4m~~)
  - A. S.S.M. set in conc/~~rock~~ has been placed/found, bearing 270° M from Mast/Plug/Pillar
  - A. G.I. Pipe set in conc/~~rock~~ has been placed/found, bearing 270° M from Mast/Plug/Pillar
  - A. set in conc/rock has been placed/found, bearing 270° M from Mast/Plug/Pillar
  - A. set in conc/rock has been placed/found, bearing 270° M from Mast/Plug/Pillar
  - Action required:

STANDPOINT: S.S.M.


| Mark                   | Direction        | Horiz. Distance | Height Difference           | Mark                   | Direction        | Horiz. Distance | Height Difference           |
|------------------------|------------------|-----------------|-----------------------------|------------------------|------------------|-----------------|-----------------------------|
| <u>Vertical G.I.</u>   | <u>0 00 00</u>   |                 | <u>above</u> standpt.       | <u>Vertical G.I.</u>   | <u>0 00 00</u>   |                 | <u>above</u> standpt.       |
| <u>S.S.M.</u>          | <u>8 56 40</u>   | <u>173</u>      | <u>0.17</u> below standpt.  | <u>G.I. Pipe</u>       | <u>102 27 30</u> | <u>4.90</u>     | <u>1.050</u> above standpt. |
| <u>G.I. Pipe</u>       | <u>82 20 30</u>  | <u>5.07</u>     | <u>0.060</u> below standpt. | <u>Brass Plug</u>      | <u>188 56 20</u> | <u>1.73</u>     | <u>0.175</u> above standpt. |
| <u>Cassiope Pillar</u> | <u>333 34 00</u> |                 | <u>above</u> standpt.       | <u>Cassiope Pillar</u> | <u>333 34 10</u> |                 | <u>above</u> standpt.       |
|                        |                  |                 | <u>above</u> standpt.       |                        |                  |                 | <u>below</u> standpt.       |
Prepared by: L. A. Hoares Checked: L. A. Hoares *Noted on U.T.M. Card*

Sr 2733-2 D. West, Government Printer

STATION Kaunsi IS 2671

Beacon Diagram

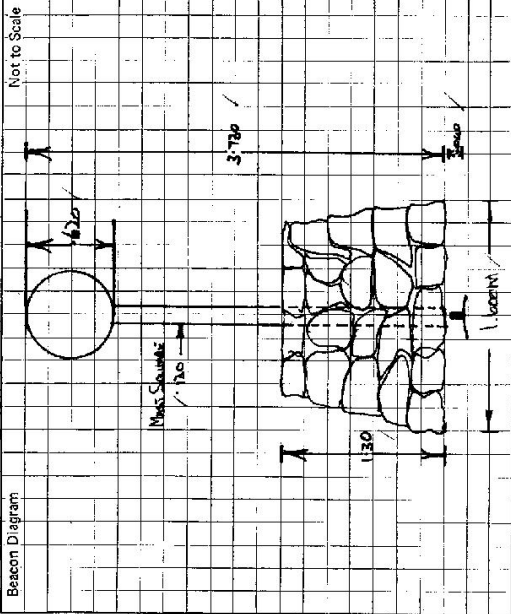

Owner's Name: .....  
 Address: .....  
 Phone: .....  
 Current Occupant: .....  
 Address: .....  
 Phone: .....

ACCESS

1. Access Report of 11/12/19. Was found suitable/unavailable.  
 2. From Signal Box on the Gangeside - Howlandoc Rd.  
 AT Signal Box Gangeside rd Kaunsi 3. Howlandoc Rd.  
 Take the Howlandoc Rd  
 Bend  
 Turn Left Signal Box. There are two signal  
 Left along road  
 Leave vehicle at T-junction - to the  
 left.

Beacon situated at Kaunsi Station

This section to be completed by officer constructing pillar.

Original station mark found/not found.

Description of mark: As Above

Original beacon found/not found.

Description of beacon: .....

Height Top of Vanes to Top Mark: .....

Height of mark: .....

Diameter of Vanes: .....

Original Beacon has/has not been destroyed by me.

Date: ..... Record of Station: .....