

GEODETIC SURVEY OF N.S.W.

CENTRAL MAPPING AUTHORITY

GEODETIC STATION RECONNAISSANCE and MAINTENANCE REPORT

- Description:
- Cleared by lanes bearing.....260°.....  
*Note: Cross out word or words which do not apply*  
 from Trig. Mast
  - Mast & Vanes have been painted white & black respectively.
  - The station/pillar was unpiled/not unpiled/constructed on.....19....., dimensions now being:  
 Description of mark.....should be explicit, e.g., S/Steel Pillar Plate, Steel plug, Brass plug, Bolt, G.I. Pipe  
 Height of mark.....1.7.....m. <sup>above</sup> rock/concrete; Mark is.....2.3.....m. <sup>above</sup> G.L.  
 Height of Top Vanes to Top Mark/Pillar plate.....m. Diameter of Vanes (vertical).....m.  
 Height of Cairn.....1.7.....m. Diameter of Cairn.....2.3.....m. Name Plate found/not found/placed.  
 Length of Mast.....3.4.....m. (approximate if not unpiled)
  - A.....set in conc/rock has been placed/found, bearing.....°M from Mast/Plug/Pillar
  - A.....set in conc/rock has been placed/found, bearing.....°M from Mast/Plug/Pillar
  - A.....set in conc/rock has been placed/found, bearing.....°M from Mast/Plug/Pillar
  - A.....set in conc/rock has been placed/found, bearing.....°M from Mast/Plug/Pillar
  - Action required:.....

STANDPOINT:

Mark	Direction	Horiz. Distance	Height Difference	Mark	Direction	Horiz. Distance	Height Difference
			above standpt.				above standpt.
			below standpt.				below standpt.
			above standpt.				above standpt.
			below standpt.				below standpt.
			above standpt.				above standpt.
			below standpt.				below standpt.
			above standpt.				above standpt.
			below standpt.				below standpt.

Prepared by: W Miller 24-1-19

Checked: Noted on U.T.M. Curt

ST 2733-1


STATION: **KEEWONG C.S** T<sup>S</sup> No.: **2674**  
 MAP SHEET SCALE 1:250 000 **CANBERRA**  
 INSPECTED BY: **W MILLER** DATE: **11.1.19**  
 AUTHORITY: **CMA** FIELD BOOK:

Station Diagram  
 North  
 Not to Scale

272° BURGA TS

Sr 2733-2 D. West, Government Printer

STATION **KEEWONG TS 2674**

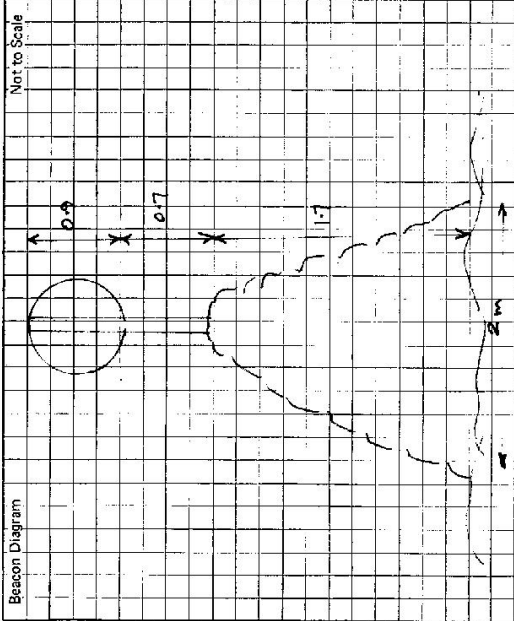

Owner's Name: .....  
 Address: .....  
 Phone: .....

Current Occupant: .....  
 Address: .....  
 Phone: .....

ACCESS

Access Report of 11.1.79 was found suitable/unusable.

At "Rock Forest" go towards steering shed. - Go through gate  
 Approx 200m past shed take track to left up to yards.  
 Go through gate and up hill to trig.  
 (In use to)

Scale approx 1:2,500,000.

Map labels: Tu Lok km, Williamsdale, Ampole, Gorge, Rock Forest, Burna, 6km, To Rensbury, To Captain's Flat, To Michalogo, To Combs.

Date: 11.1.79

Record of Station: Misused 1979

This section to be completed by officer constructing pillar.

Original station mark found/not found.

Description of mark: .....

Original beacon found/not found.

Description of beacon: .....

Height Top of Vanes to Top Mark.....m.

Height of mark.....m. above G.L. below

Diameter of Vanes.....m.

Original Beacon has/has not been destroyed by me.

Height of Cairn.....m.