

Department of Lands  
 RECONNAISSANCE and MAINTENANCE REPORT

and vicinity of N.S.W.

This Trig. Station has been:-

Note: Cross out word or words which do not apply

1. Completely cleared to permit 360° vision to surrounding Trigs.
2. Cleared by lanes bearing..... from Trig. Mast
3. Trig. Mast & Vanes have been painted white & black respectively.
4. The Trig. was unpiled/not unpiled, dimensions now being:
  - Description of mark..... should be explicit, e.g. Steel plug, Brass plug, Bell; Concrete Pillar
  - Height of mark..... m <sup>above</sup> <sub>below</sub> rock concrete..... m <sup>above</sup> <sub>below</sub> G.L.
  - Height of Top Vanes to Top Mark/Top pillar plate..... m. Diameter of Vanes (vertical)..... m.
  - Height of Cairn..... m. Diameter of Cairn..... m.
  - Length of Mast..... m. (approximate if not unpiled)
5. A..... set in conc./rock has been placed/fd..... m. bearing.....°M from Trig. Mast/pillar
6. A..... set in conc./soil has been placed/fd..... m. bearing.....°M from Trig. Mast/pillar
7. A..... set in conc./soil has been placed/fd..... m. bearing.....°M from Trig. Mast/pillar
8. A..... set in conc./rock has been placed/fd..... m. bearing.....°M from Trig. Mast/pillar

9. Connection..... to..... m. bearing.....°M
10. Connection..... to..... m. bearing.....°M
11. Connection..... to..... m. bearing.....°M
12. Connection..... to..... m. bearing.....°M
13. Diff. Ht. .... is..... m. <sup>above</sup> <sub>below</sub>
14. Diff. Ht. .... is..... m. <sup>above</sup> <sub>below</sub>
15. Diff. Ht. .... is..... m. <sup>above</sup> <sub>below</sub>
16. Diff. Ht. .... is..... m. <sup>above</sup> <sub>below</sub>

Prepared by: \_\_\_\_\_ Checked: \_\_\_\_\_


STATION **KEIRA Steel OP TS 2676**

Co: **CARDEN** | Ph: **WONONA** | No: \_\_\_\_\_

Map Sheet: \_\_\_\_\_ | Inspected by: **H. BORDER** | Date: **21/1/91**

Authority: **LIC, SYDNEY** | Field Book: \_\_\_\_\_

Beacon Diagram: \_\_\_\_\_ | Net to Scale

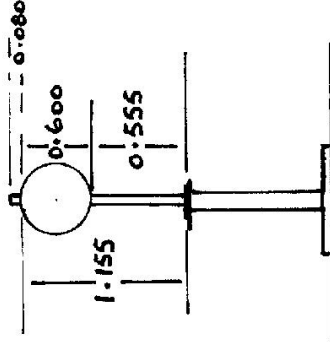

Date: **21/1/91** | Record of Station: **NEW MAST & VANES**

Survey Co-ordination Act, 1949.



VERA T.S.  
 TS No. 2676  
 S.C. ....


**LOCALITY SKETCH PLAN**

(To be drawn in black waterproof ink, or HB pencil, not necessarily to scale.)

Parish KINDONIA County CAMDEN City or Town GREATER HOLLINGBONG  
 Municipality or Shire.....Survey Area.....  
 Zone..... Map Sheet..... Aerial Photograph N.S.W. ....

NOTE - Measurements are to be shown from the mark to as many nearby survey marks, buildings, fence posts, kerbs, etc., as practicable. Up to six measurements are desirable.

Measurements are in feet 24 MSL

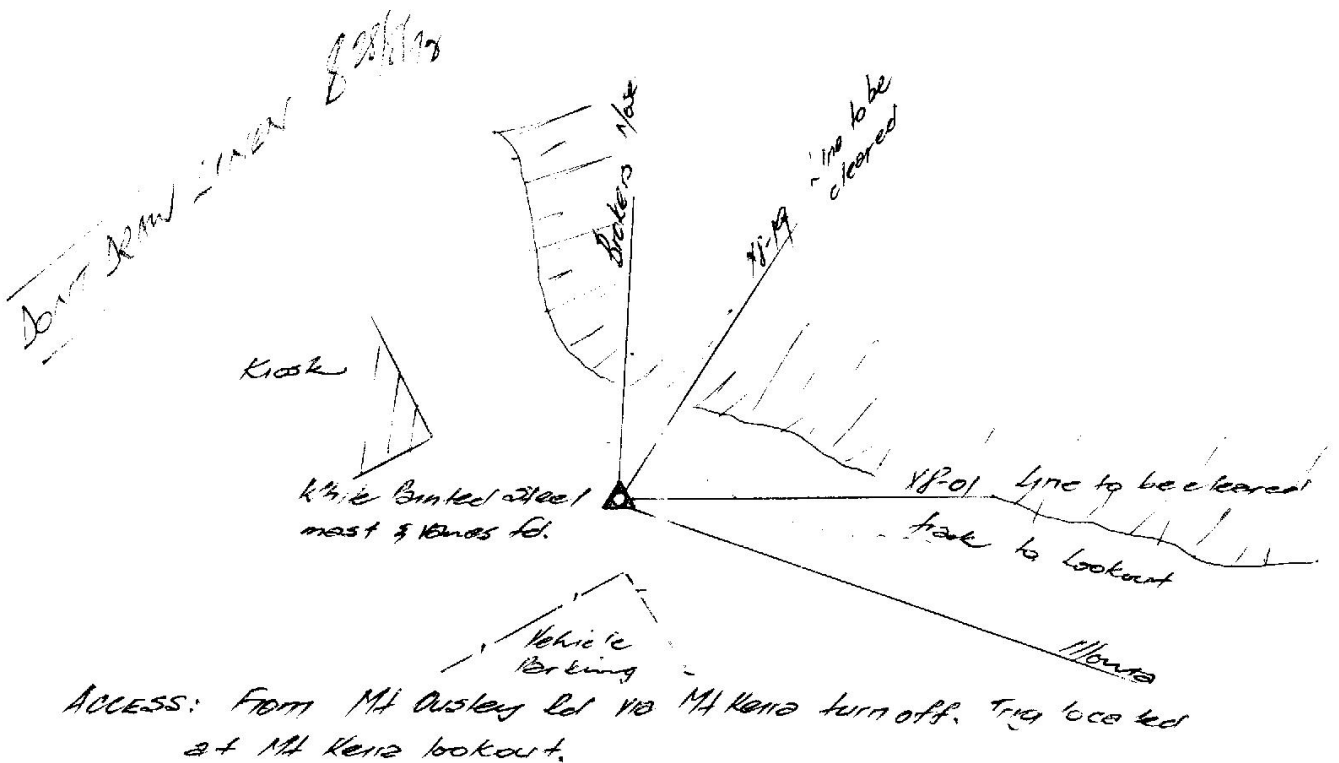

Mark last inspected .....  
 Placed in connection with (type of survey or work).....  
 Co-ordinate values of mark.....  
 Projection..... Origin.....  
 Reduced level of mark..... feet (prov.)..... to Datum + Standard.....  
 Inspection Book No. 518 Fol. 2  
 Site selected by .....  
 Mark placed by ..... Date .....  
 Locality sketch drawn by JMK Date 11-8-71  
 Locality sketch put into use by ..... Date .....

PROVISIONAL SKETCH ONLY

PM No. ....

Officer-in-Charge  
 Survey Co-ordination Branch