

CENTRAL MAPPING AUTHORITY  
Department of Lands

Trigonometrical Survey of N.S.W.

RECONNAISSANCE and MAINTENANCE REPORT

This Trig. Station has been:-

Note: Cross out word or words which do not apply

1. Completely cleared to permit 360° vision to surrounding Trigs.
2. Cleared by lances bearing... **LIGHT CLEARING NEEDED FOR 360° VISION** ... from Trig. Mast
3. Trig-Mast & Vanes have been painted white & black respectively.
4. The Trig. was ~~unpiled~~/not unpiled, dimensions now being: ~~2.5m~~ <sup>3.0m</sup> ~~1.05m~~ <sup>1.105m</sup>

Description of mark..... should be explicit, e.g. Steel plug, Brass plug, Bolt, G.I. Pipe

Height of mark..... m above rock/concrete ..... m above G.L.

Height of Top Vanes to Top Mark..... m. Diameter of Vanes (vertical) 1/05 m.

Height of Cairn 1.6 m. Diameter of Cairn 2.8m.

Length of Mast 4.1m. (approximate if not unpiled)

5. A. **TRIANGLE** set in conc/rock has been placed **3.78** m. bearing.....°M from Trig. Mast
6. A..... set in conc/soil has been placed..... m. bearing.....°M from Trig. Mast
7. A..... set in conc/soil has been placed..... m. bearing.....°M from Trig. Mast
8. A..... set in conc/rock has been placed..... m. bearing.....°M from Trig. Mast

9. Connection..... to..... m. bearing.....°M

10. Connection..... to..... m. bearing.....°M

11. Connection..... to..... m. bearing.....°M

12. Connection..... to..... m. bearing.....°M

13. Diff. Ht. **Triangle on rock pd.** is **1.18** m. ~~above~~ <sup>below</sup> **Bottom of Vanes**.

14. Diff. Ht. .... is..... m. <sup>above</sup> ~~below~~

15. Diff. Ht. .... is..... m. <sup>above</sup> ~~below~~

16. Diff. Ht. .... is..... m. <sup>above</sup> ~~below~~

Prepared by: Alan Wood Checked: Jeff Barrett 19-5-77 Noted on U.T.M. Card

Checked

STATION **KERLEWIS G.S. TS 2696**

Co: \_\_\_\_\_ Ph: \_\_\_\_\_ No: \_\_\_\_\_

Map Sheet: **NUMBLA 1:100,000**

Inspected by: **W. MILLER, R. LANDER**


Date: **7<sup>th</sup> FEBRUARY 77.**

Authority **CENTRAL MAPPING**

Field Book: **1536.**

Beacon Diagram

Not to Scale

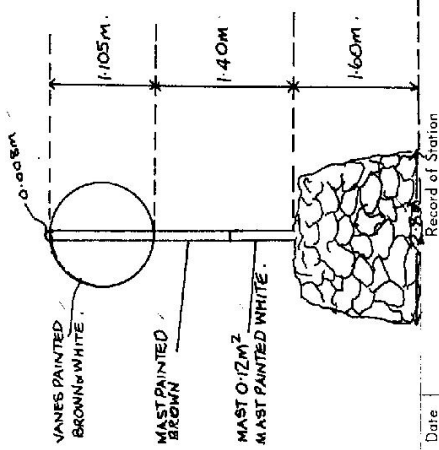

Date

Record of Station

