

CENTRAL MAPPING AUTHORITY

GEODETIC STATION RECONNAISSANCE and MAINTENANCE REPORT

Description:

1. Cleared by lanes bearing **Clear** except for scattered shade trees from Trig. Mast
2. Mast & Vanes have been painted white & black respectively.
3. The station/pillar was unplaced/not unplaced/removed on 19....., dimensions now being:
Description of mark..... should be explicit, e.g., S/Steel Pillar Plate, Steel plug, Brass plug, Bolt, G.I. Pipe
Height of mark..... m. ^{above} rock/concrete; Mark is..... m. ^{above} G.L.
Height of Top Vanes to Top Mark/Pillar plate 2.55 m. Diameter of Vanes (vertical) 0.63 m.
Height of Cairn 1.20 m. Diameter of Cairn 2.5 m. Name Plate found/not found/placed.
Length of Mast 3.75 m. (approximate if not unplaced)

4. A..... set in conc/rock has been placed/found, bearing.....° M from Mast/Plug/Pillar
5. A..... set in conc/rock has been placed/found, bearing.....° M from Mast/Plug/Pillar
6. A..... set in conc/rock has been placed/found, bearing.....° M from Mast/Plug/Pillar
7. A..... set in conc/rock has been placed/found, bearing.....° M from Mast/Plug/Pillar

8. Action required:.....
STANDPOINT:..... HANWORTH
1:25,000

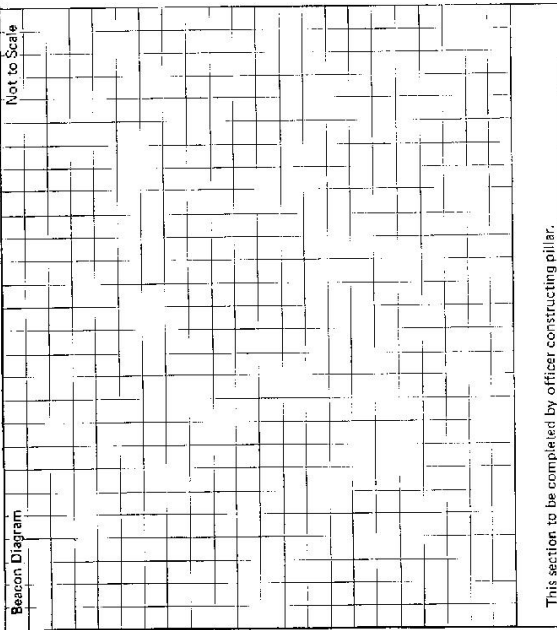
Mark	Direction	Horiz. Distance	Height Difference	Mark	Direction	Horiz. Distance	Height Difference
			above standpt.				above standpt.
			below				below
			above standpt.				above standpt.
			below				below
Prepared by: *[Signature]* Checked: *[Signature]*
Noted on U.T.M. Card

STATION: **KERRAWAY** TS No.: **2698**
 MAP SHEET SCALE 1:250 000 **Wollongong**
 INSPECTED BY: **A. Sivertsen** DATE: **8-11-78**
 AUTHORITY: **CMA** FIELD BOOK: **1717**

Station Diagram
 North
 Cairn Mast & Vanes in fair condition
 Nundolls Δ 86°M
 St. Pauls (Hil) 355°M
 Close ridge 121-187°M
 Fair Δ site +

Not to Scale

Sl. 2793-2 D. West, Government Printer Beacon Diagram Not to Scale 	<p style="text-align: center;">STATION KERRAWARY TS 2698</p> <p>Owner's Name: Address: Phone:</p> <p>Current Occupant: Address: Phone:</p> <p style="text-align: center;"><u>ACCESS</u></p> <p>Access Report of 8.11.1928 was found suitable/unsuitable.</p> <p>On MARULAN - BIG HILL road about 18 km from MARULAN at sign</p> <p>0.0 GREENWICH PARK 5 GOULBURN 18 MARULAN 18</p> <p>2.8 Take R fork towards BIG HILL</p> <p>3.7 Turn L towards BIG HILL</p> <p>9.4 Grid then turn R</p> <p>11.9 Gate - straight ahead</p> <p>12.9 Gate</p> <p>13.9 Gate</p> <p>14.5 Take left fork towards gate. (R fork to owners)</p> <p>14.6 Gate</p> <p>15.7 Gate</p> <p>16.1 Gate . Follow fence down</p> <p>16.35 Take gate on R & make own way to Δ</p> <p>17.0 Δ KERRAWARY</p>	<p>This section to be completed by officer constructing pillar.</p> <p>Original station mark found/no: found.</p> <p>Description of mark:</p> <p>Original beacon found/not found.</p> <p>Description of beacon:</p> <p>Height Top of Vanes to Top Mark.....m.</p> <p>Height of mark.....m. above G.L. below</p> <p>Diameter of Vanes.....m. Height of Cairn.....m.</p> <p>Original Beacon has/has not been destroyed by me.</p>
		Date Period of Station