


7.5 10

Department of Lands
 STATION TS 2729 KING (P)
 Co: Gloucester
 Map Sheet: Newcastle
 Inspected by: A Graham
 Authority: ISD NCELE
 No: 9232
 Date: 22.1.17
 Field Book: P/S/S

RECONNAISSANCE and MAINTENANCE REPORT
 Note: Cross out word or words which do not apply

- This Trig. Station has been:-
1. Completely cleared to permit 360° vision to surrounding Trigs. ✓
 2. ~~Greened~~ by ~~lines~~ bearing ~~from Trig. Mast~~
 3. Trig. Mast & Vanes have been painted white & black respectively. ✓
 4. The Trig. was unpiled/~~not supported~~, dimensions now being:
 - Description of mark: ~~concrete~~ pillar should be explicit, e.g. Steel plug, Brass plug, Bolt, Concrete Pillar
 - Height of mark: ~~1.35~~ 1.35 m above rock/concrete ~~below~~ G.L.
 - Height of Top Vanes to ~~Top Mark~~ Top pillar plate: ~~1.45~~ 1.45 m Diameter of Vanes (vertical): ~~0.60~~ 0.60 m.
 - Height of Cairn: ~~1.35~~ 1.35 m. Diameter of Cairn: ~~33~~ 33 x ~~55~~ 55 m.
 - Length of Mast: ~~1.54~~ 1.54 m. (approximate if not unpiled)
 5. A. Trig Plug set in conc/~~rock~~ has been placed/~~td~~ 3 45.7 m bearing 60 °M from Trig. Mast/pillar
 6. A. SSM 23818 set in conc/~~soil~~ has been placed/~~td~~ 4 246 m bearing 18 °M from Trig. Mast/pillar
 7. A. ~~set in conc/soil~~ has been placed/~~td~~ 3 45.7 m bearing 60 °M from Trig. Mast/pillar
 8. A. ~~set in conc/rock~~ has been placed/~~td~~ 3 45.7 m bearing 60 °M from Trig. Mast/pillar
 9. Connection: Trig. Plug to SSM 23818 2 880 m bearing 323 °M
 10. Connection: ~~to~~ to to m bearing °M
 11. Connection: ~~to~~ to to m bearing °M
 12. Connection: ~~to~~ to to m bearing °M
 13. Diff. Ht. SSM 23818 is 1 570 m below Pillar Plate
 14. Diff. Ht. Old Trig Plug is 1 435 m above Pillar Plate
 15. Diff. Ht. is is is m above below
 16. Diff. Ht. is is is m above below

Prepared by: AGD Checked: SP

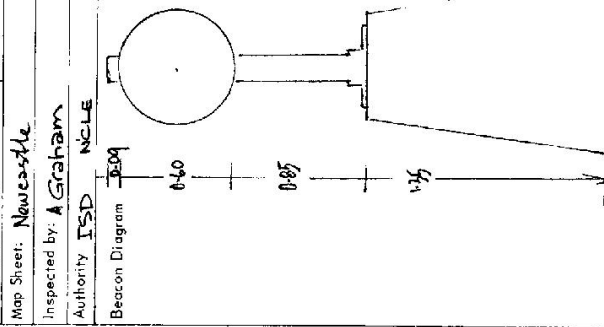


Date	Record of Station
5/17	Pillar Erected

STATION TS 272 KING (P) TS 2729

Owners Name: B.M.G. - Raymond Terrace
 Current Occupant: B.M.G.
 Address: Raymond Terrace

Access 22.7.1977
 Km. feature.
 Raymond Terrace Police Stn. Travel north along Pacific Hwy.
 0.0 Left off Highway into B.M.G. Property - Irrawong Estate
 5.95 Road off Highway road onto track, just before grid.
 7.30 Gate - follow clear track to Trig
 7.45 TRIG.
 8.6

Conventional vehicle access in dry weather.

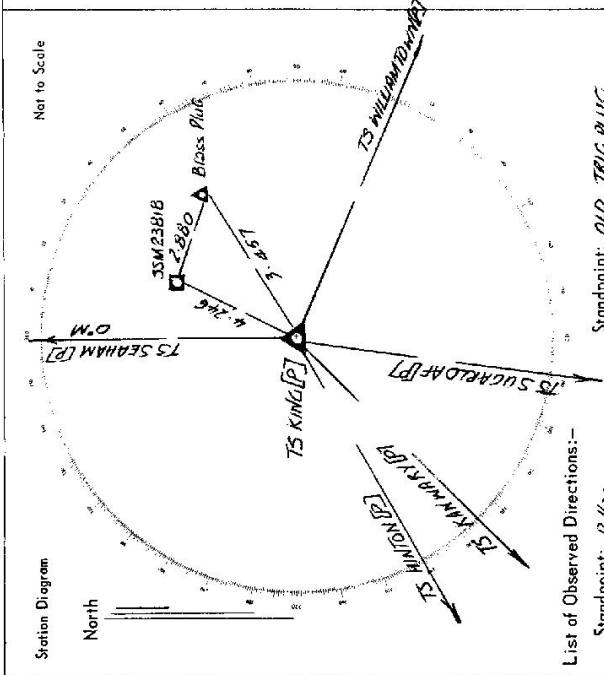

List of Observed Directions:-

Station	Direction	Station	Direction
TS SEAHAM [P]	0° 00' 00"	TS SEAHAM [P]	0° 00' 00"
SSM 23818	18° 05'	TS KING [P]	240° 32' 10"
PHI TOLD TRIG (Rd)	60° 29'	TS HANTON [P]	251° 45' 54"
TS WILLIAMTOWN [P]	126° 11' 43.1"	SSM 23818	324° 08' 50"
TS SUGARLOAF [P]	214° 30' 24.6"		
TS HANTON [P]	251° 43' 25"		
TS KINMONT [P]			
TS SUGARLOAF [P]			

Standpoint: OLD TRIG. PLUG.

16/11/2016
 16/11/2016