

CENTRAL MAPPING AUTHORITY  
Department of Lands

Trigonometric Survey of N.S.W.

RECONNAISSANCE and MAINTENANCE REPORT

This Trig. Station has been:-

Note: Cross out word or words which do not apply

1. Completely closed to public for use in connection with Trig.
2. Closed by fence having ..... See Over ..... from Trig. Mast
3. Trig. Mast & Vanes have been painted white & black respectively.
4. The Trig. was supplied/foot supplied, dimensions now being: .....  
Description of work: Stainless Steel, Pa. m., Concrete, Block... should be explicit, e.g. Steel plug, Brass plug, Belt, G.I. Pipe

Height of mark..... m above rock/concrete ..... m above G.L.  
Height of Top Vanes to Top Mark..... m. Diameter of Vanes (vertical), Old..... m.

Height of Cairn..... m. Diameter of Cairn..... m.

Length of Mast..... m. (approximate if not supplied)

5. A..... set in conc/rock has been placed..... m from Trig. Mast
6. A..... set in conc/soil has been placed..... m from Trig. Mast
7. A..... set in conc/soil has been placed..... m from Trig. Mast
8. A..... set in conc/rock has been placed..... m from Trig. Mast

9. Connection..... to..... m. bearing..... M
10. Connection..... to..... m. bearing..... M
11. Connection..... to..... m. bearing..... M
12. Connection..... to..... m. bearing..... M

13. Diff. Ht. .... is..... m. above below
14. Diff. Ht. .... is..... m. above below
15. Diff. Ht. .... is..... m. above below
16. Diff. Ht. .... is..... m. above below


Prepared by: .....

Checked: .....

Noted on U.T.M. Card

TS 2733 **KINGS CREEK**  
STATION **KINGS CREEK (S 28)**


Co: CAMDEN  
Map Sheet: MARGAROO VALLEY C.M.A. 1:25000  
Inspected by: M. W. S. & D. B.  
Authority: M. W. S. & D. B.  
Date: 1966  
Field Book:  
No. 9028-IV-S  
1966  
Not to Scale

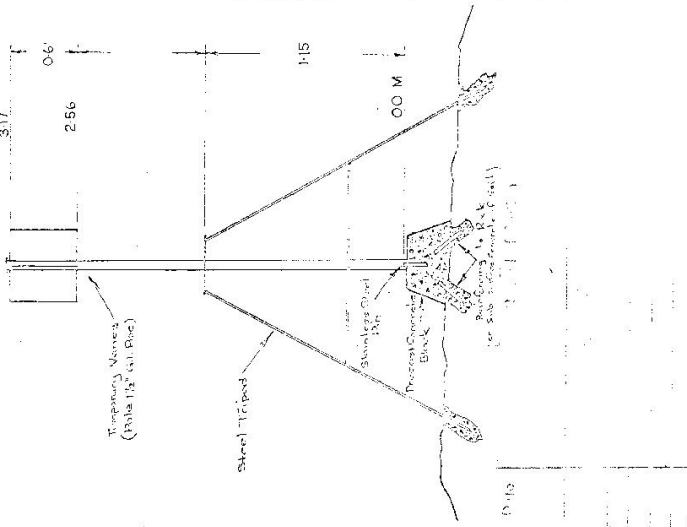

Checked

STATE: KINGS CREEK (S 28) T5 2733

Owners Name: .....  
 Address: .....  
 Address: 1966

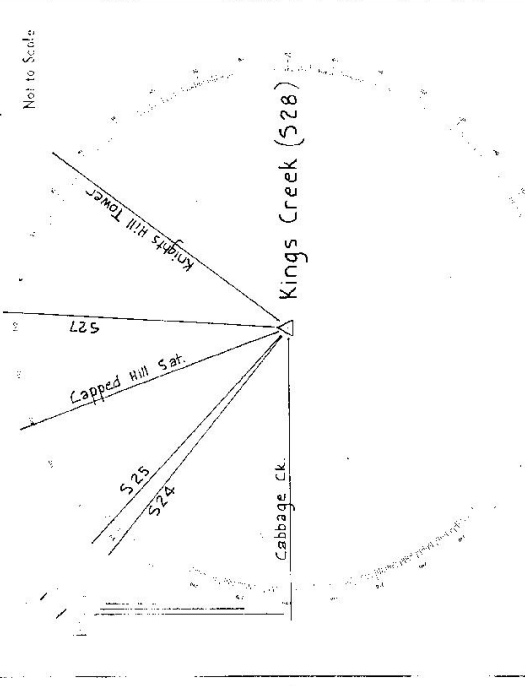

List of Observed Directions:

Station	Direction	Station	Direction
S 27	0°00'00.00	S 27	0°00'00.00
Knights Hill Tower	S 11°35'26.32 54	Knights Hill Tower	S 11°35'26.32 54
Cabbage Ck.	S 26°26'47.54 19	Cabbage Ck.	S 26°26'47.54 19
S 24	S 05°50'42.06	S 24	S 05°50'42.06
S 25	S 09°54'58.89	S 25	S 09°54'58.89
Mean 10 Sets (S1 = FL/R)			
Capped Hill Sat.	S 15°33'09.01 49	Capped Hill Sat.	S 15°33'09.01 49

