

Department of Lands

82-5177 TS 2747

Control Mapping Authority

Trigonometrical Survey of N.S.W.

RECONNAISSANCE and MAINTENANCE REPORT on K.S.G.M.T. TRIG. STATION

Parish North Cobah County Cumberland Map Sheet Hornsby No. 100

Inspected by Trig. Surveyor J. J. J. J. Date of Inspection 29th May 1969

Trig. Station has been:- Note: Cross out word or words which do not apply

1. Completely cleared to permit 360° vision to surrounding Trigs.
2. Cleared by lanes bearing on timbered ridge from Trig. Mast
3. The Trig. was unpiled/not unpiled, dimensions now being:

Original Trig. Plug was found/not found.

Length of Mast                      feet (approximate if not unpiled) Mast (Round                      feet diameter  
(Square                      feet

Height of Trig. Plug                      feet (above rock/concrete)

Height of Top Vanes to Top Trig. Plug                      feet Diameter of Vanes (vertical)                      feet

Height of Cairn                      feet Diameter of Cairn                      feet


(If other type Trig. beacon is erected - Diagram is required below in Remarks)

4. Trig. Mast & Vanes have been painted white & black respectively.
5. An S.S.M. set in conc/rock has been placed                      feet bearing                     ° M to Trig. Mast/Plug
6. A G.I. Pipe set in conc/soil has been placed                      feet bearing                     ° M to Trig. Mast/Plug
7. Connection S.S.M. to G.I. Pipe                      feet bearing                     ° M

REMARKS:- (To include diagram of marks placed)

North

Mast and vanes gone.  
Broken down cairn found with solid plug exposed.  
Cairn repaired sufficient to hide plug.

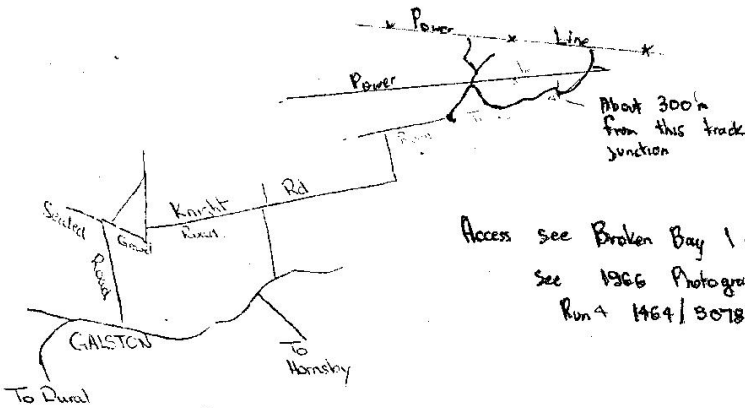

Access see Broken Bay 1 mile  
see 1966 Photograph  
Run 4 1464/3078

card noted  
Phillips  
23/10/70  
J.M. [initials]

Signature J. J. J. J.

Department of Lands

Central Mapping Authority

Trigonometrical Survey of N.S.W.

RECONNAISSANCE and MAINTENANCE REPORT on KNIGHT T.S. 2747 TRIG. STATION

Parish NORTH COLAH County CUMBERLAND Map Sheet ARCADIA No. 0075

Inspected by B. G. HANNA Date of Inspection 18th JULY 1972


Trig. Station has been:-

Note: Cross out word or words which do not apply

1. Completely cleared to permit 360° vision to surrounding Trigs.
2. Cleared by luns bearing ..... from Trig. Mast
3. The Trig. was unipiled/~~not unipiled~~. dimensions now being:
  - Original Trig. Plug was found/~~not found~~.
  - Length of Mast ..... feet (approximate if not unipiled) Mast (Round ..... feet diameter (Square ..... feet)
  - Height of Trig. Plug ..... feet (above rock/concrete) Diameter of Vanes (vertical) ..... feet
  - Height of Top Vanes to Top Trig. Plug ..... feet Diameter of Cairn ..... feet
  - Height of Cairn ..... feet
- (If other type Trig. beacon is erected - Diagram is required below in Remarks)
4. Trig. Mast & Vanes have been painted white & black respectively.
5. An S.S.M. set in conc/rock has been placed ..... feet bearing .....° M to Trig. Mast/Plug
6. A G.I. Pipe set in conc/soil has been placed ..... feet bearing .....° M to Trig. Mast/Plug
7. Connection S.S.M. to G.I. Pipe ..... feet bearing .....° M

REMARKS:- (To include diagram of marks placed)

North

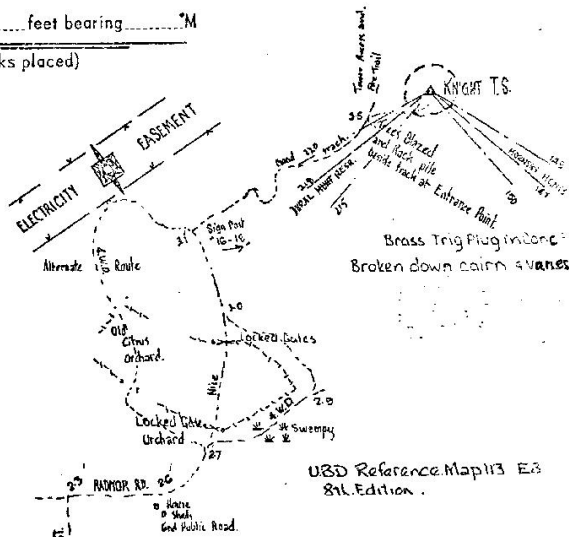

CARDS METED: MICHAEL MURPHY; 11th APRIL 1973.

USD Reference Map 1:3 E.3 8th Edition.

*David Nimant*  
 SENIOR SURVEYOR  
 7 JULY 1972

Department of Lands

Central Mapping Authority

Trigonometrical Survey of N.S.W.

RECONNAISSANCE and MAINTENANCE REPORT on KNIGHT T.S. 2747 TRIG. STATION

Parish North Colah County Cumberland Map Sheet Sydney North No. 103

Inspected by M. Morrison Date of Inspection 16 October 1973

Trig. Station has been:-

Note: Cross out word or words which do not apply

1. Completely cleared to permit 360° vision to surrounding Trigs.
2. Cleared by lanes bearing ..... from Trig. Mast
3. The Trig. was unpiled/not-unpiled, dimensions now being:

Original Trig. Plug was found/not-found.

Length of Mast ..... feet (approximate if not unpiled) Mast (Round ..... feet diameter;  
 (Square ..... feet)  
 Height of Trig. Plug ..... feet (above rock/concrete)  
 Height of Top Vanes to Top Trig. Plug ..... feet Diameter of Vanes (vertical) ..... feet  
 Height of Cairn ..... feet Diameter of Cairn ..... feet

(If other type Trig. beacon is erected - Diagram is required below in Remarks)

4. Trig. Mast & Vanes have been painted white & black respectively.
5. An S.S.M. set in conc/rock has been placed ..... feet bearing ..... M to Trig. Mast/Plug
6. A G.I. Pipe set in conc/soil has been placed ..... feet bearing ..... M to Trig. Mast/Plug
7. Connection S.S.M. to G.I. Pipe ..... feet bearing ..... M

REMARKS:- (To include diagram of marks placed)

North

Access. See 1969 access prepared by J. Judge

Lanes Rd cleared to Rural Res T.S. and  
 to a station established by the M.W.S. - D.B.  
 on line to Hornsby Heights Res T.S.

Trig Plug has been levelled by C. Brown --  
 See levelling abstract.

Records noted  
 R.R.

AC