

CENTRAL MAPPING AUTHORITY
Department of Lands

Trigonometrical Survey of N.S.W.

RECONNAISSANCE and MAINTENANCE REPORT

STATION KOOREE T.S. (Pillar) 2759

This Trig. Station has been:-

Note: Cross out word or words which do not apply

1. Completely cleared to permit 360° vision to surrounding Trigs.
2. ~~Cleared by James~~ bearing from Trig. Mast
3. Trig. Mast & Vanes have been painted white & black respectively.
4. The Trig. was unpiled/not unpiled, dimensions now being:

Description of mark C.P. should be explicit, e.g. Steel plug, Brass plug, Bolt, G.I. Pipe
 Height of mark m above rock/concrete m above G.L.
 Height of Top Vanes to Top Mark 1.455 m. Diameter of Vanes (vertical) 0.75 m.
 Height of Cairn m. Diameter of Cairn m.

Length of Mast m. (approximate if not unpiled)

5. A Trig. Plug set in conc/rock has been ^{found} placed 2.010 m. bearing 2.44.0M from Trig. Mast (Pillar)
6. A G.I. Pipe set in conc/soil has been ^{found} placed 1.835 m. bearing 339.0M from Trig. Mast (--->)
7. A G.I. Pipe set in ~~conc~~/soil has been ^{found} placed 2.620 m. bearing 106.0M from Trig. Mast (--->)
8. A set in conc/rock has been placed m. bearing 0M from Trig. Mast

9. Connection Trig. Plug to G.I. Pipe in ~~conc~~ : 2.800 m. bearing 0M
10. Connection Trig. Plug to G.I. Pipe in ~~soil~~ : 4.355 m. bearing 0M
11. Connection ~~Trig. Plug~~ in ~~conc~~ to G.I. Pipe in ~~soil~~ : 3.990 m. bearing 0M


12. Connection to m. bearing 0M
13. Diff. Ht. Top of Pillar is 1.410 m. ^{above} ~~below~~ Trig. Plug in ~~conc~~.
14. Diff. Ht. is 1.295 m. ^{above} ~~below~~ G.I. Pipe in ~~conc~~.
15. Diff. Ht. is 1.485 m. ^{above} ~~below~~ G.I. Pipe in ~~soil~~.
16. Diff. Ht. is ^{above} ~~below~~ ^{below} ~~below~~

Prepared by: A. Hunter 10.7.74 Checked: P. Brown 12/7/74 Noted on U.T.M. Card 26/1/75

Co: Northumberland
 Map Sheet: GOSFORD
 Inspected by: E. Garcia
 Authority: C. M. A.

Ph: Kooree and Stone
 No: 9131 - N
 Date: 2 July 1974
 Field Book: 1358 AB

Beacon Diagram
 Not to Scale

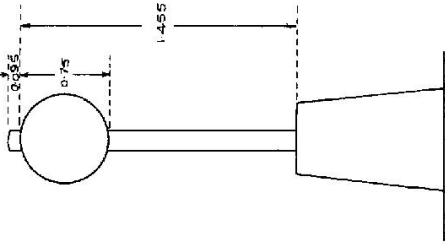



Date	Record of Station

Checked

STATION KOOREE TS (Pillar) 2759

Owners Name:
 Current Occupant:
 Address:
 Address:

2-7-1974
 0.00 KULUURA Rd intersection Drive N
 180m Kyda Rd on left.
 2.30 mile Turn right (Urban) drive back along ridge to trig (AWD)
 (Mileages not exact)

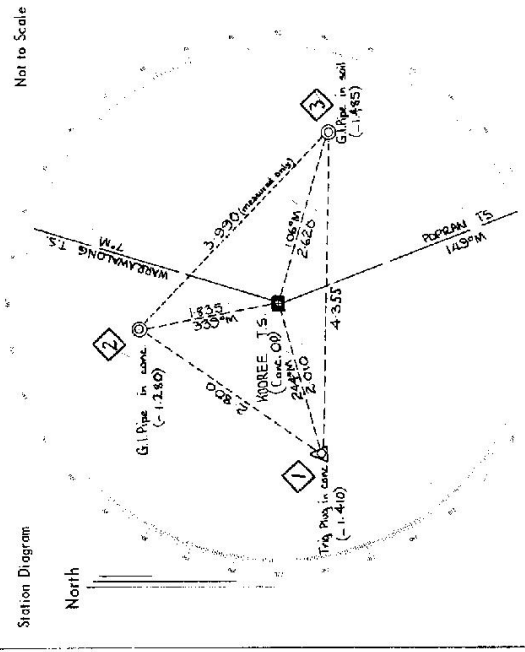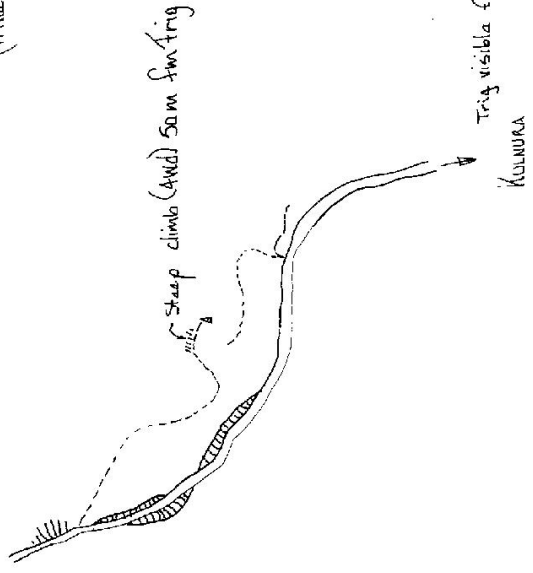

Station Diagram
 Not to Scale
 North

List of Observed Directions:-

Station	Conc. o.p.	Direction	Station	Trig Plug in conc.	Direction
WARRAWALONG TS	352° 59' 60"		POPRAN TS (Pillar)	349° 59' 60"	
G.I. Pipe in soil	98° 12'		WARRAWALONG TS	217° 11' 40"	
POPRAN TS (Pillar)	142° 49' 26"		G.I. Pipe in conc.	254° 47'	
Trig Plug in conc.	238° 25'		Kooree TS (Pillar)	275° 40'	
G.I. Pipe in conc.	331° 52'		G.I. Pipe in soil	298° 14'	

Station	Direction