

CENTRAL MAPPING AUTHORITY

Department of Lands

Trigonometrical Survey of N.S.W.

RECONNAISSANCE and MAINTENANCE REPORT

This Trig. Station has been:-

Note: Cross out word or words which do not apply

1. Completely cleared to permit 360° vision to surrounding Trigs.
2. Cleared by lances bearing..... from Trig. Mast
3. Trig. Mast & Vanes have been painted white & black respectively, & left at the MAST POINT VILLAGE
IN THE MOUNTAINS, WITH THE RED LANTERN OF NATIONAL PARKS & WILDLIFE SERVICE.
4. The Trig. was unpiled/not unpiled, dimensions now being:.....

Description of mark..... TRIG. FLAG IN ROCK should be explicit, e.g. Steel plug, Brass plug, Bolt, G.I. Pipe

Height of mark..... m above rock/concrete..... m below G.L.

Height of Top Vanes to Top Mark..... m. Diameter of Vanes (vertical)..... m.

Height of Cairn..... m. Diameter of Cairn..... m.

Length of Mast..... m. (approximate if not unpiled)

5. A. DRILL HOLE set in conc/rock has been placed 4.208 m. bearing 75°M from Trig. Mast

6. A. IRON BOLT set in conc/rock has been placed 4.216 m. bearing 131°M from Trig. Mast

7. A. BRASS BOLT set in conc/rock has been placed 3.288 m. bearing 188°M from Trig. Mast

8. A..... set in conc/rock has been placed..... m. bearing.....°M from Trig. Mast

9. Connection..... DRILL HOLE BRASS BOLT to..... 6.728 m. bearing 220°M

10. Connection..... to..... m. bearing.....°M

11. Connection..... to..... m. bearing.....°M

12. Connection..... to..... m. bearing.....°M

13. Diff. Ht. DRILL HOLE IN PY is 0.250 m. below TRIG. FLAG

14. Diff. Ht. IRON BOLT IN CONC is 0.452 m. above TRIG. FLAG

15. Diff. Ht. BRASS BOLT IN CONC is 0.189 m. above TRIG. FLAG

16. Diff. Ht. is..... m. above..... m. below.....

Prepared by: Q O'SHAMNESSY 11/10/76 Checked: J.C. 12/10/76 Noted on U.T.M. Card

STATION KOSCIUSKO 75 2761

Co: Selwyn & Millice Ph: Kosciusko

Map Sheet: KOSCIUSKO No: 8525

Inspected by: J.R. Millice Date: 6/4/1976

Authority: C.M.A. Field Book: 1320 Fol. 15/19

Beacon Diagram

Not to Scale

A CONCRETE OBSERVATION PILLAR HAS BEEN CONSTRUCTED CONCENTRICALLY ABOVE TRIG FLAG IN ROCK.

Date

Record of Station

Checked

STATION KOSCIUSKO TS. 2761


Owners Name National Parks & Wildlife Service Current Occupant

Address Serpent Creek Address

National Park Access

Not to Scale

Station Diagram
GNIP
North

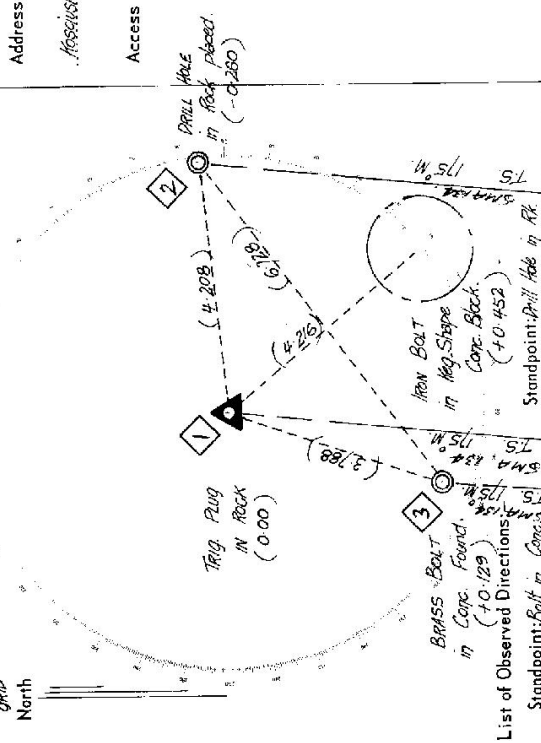

List of Observed Directions
Standpoint: Bolt in Conc.


Station	Direction	Station	Direction
TS	0 00 00	TS	0 00 00
Trig. Plug	132 45	Bolt in Conc.	47 22 00
Drill Hole in Rock	227 27 00	Trig. Plug	78 12
Standpoint: Trig Plug in Rock			
Station	Direction	Station	Direction
TS	0 00 00		
Bolt in Conc.	12 43		
Drill Hole in Rock	258 17		

STATION KOSCIUSKO T.S. (Pillar) 2761

Owners Name: National Parks and Wildlife Service
 Current Occupant:
 Address: Sawpit Creek
 Kosciusko National Park

6-4-1974

Access Proceed from Jindabyne to Mr Reg Lemaitre of the Waste Point Village to obtain mast and vanes if necessary for observations.
 Continue along the road to the Sawpit Creek Ranger Station for the keys to any gates.
 Follow the road to Rawsons Pass Parking Area.
 Four wheel drive is necessary to scale the bank at the far end of the parking area where the road continues to the trig.

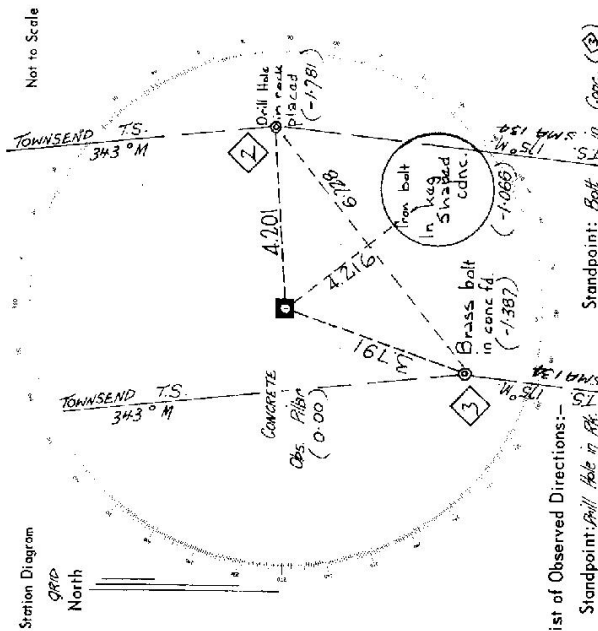

List of Observed Directions:-

Station	Direction	Station	Direction
Sawpit Creek T.S.	0. 00. 00	Sawpit Creek T.S.	0. 00. 00
Bolt in Conc.	47. 23. 00	TOWNSEND T.S.	168. 02. 40
Centre Pillar Plate	78. 15. 00	Centre Spigot	192. 42. 00
TOWNSEND T.S.	167. 52. 53	Pillar Hole	227. 26. 00

Jindabyne Sawpit Creek Smugglers Holes -
 Rawsons Pass -
 Waste Point -
 Kosciusko T.S. 2761

GEODEIC SURVEY OF NSIK

CENTRAL MAPPING AUTHORITY

GEODEIC STATION RECONNAISSANCE and MAINTENANCE REPORT

STATION: **KOSCIUSKO G.S.** No.: **T^S 2761**

MAP SHEET: **TALLANGATTA**

SCALE: **1:250 000**

INSPECTED BY: **A. WOODRUFF** DATE: **17th MARCH 1979**

AUTHORITY: **CENTRAL MAPPING** FIELD BOOK: **1526**

- Description:
1. Cleared by lances bearing **360° VISION**. *Note: Cross out word or words which do not apply*
2. Mast & Vanes have been painted white & black respectively. **MAST & VANES ARE AT WASTE POINT DEPOT.**
GRANITEXED & PAINTED
3. The station/pillar was ~~unpiled~~ **not unpiled/constructed on** **17th MARCH 1979**, dimensions now being:
- Description of marks: **STEEL PILLAR** should be explicit, e.g., S/Steel Pillar Plate, Steel plug, Brass plug, Bolt, G.I. Pipe
- Height of mark: **1.222m** above rock/concrete; Mark is **0.173m** above below G.L.
- Height of Top Vanes to Top Mark/Pillar plate **1.385m**; Diameter of Vanes (vertical) **0.173m**.
- Height of Cairn: **0.173m**; Diameter of Cairn **0.173m**; Name Plate **found/not found/placed**.
- Length of Mast **0.173m** (approximate if not unpiled)
4. ~~STEEL BOLT~~ **BOLT** set in conc/rock has been placed/found, bearing **120°**, **0.173m** from Mast/Plug/Pillar
5. ~~STEEL BOLT 'A'~~ **STEEL BOLT 'A'** set in conc/rock has been placed/found, bearing **225°**, **0.173m** from Mast/Plug/Pillar
6. ~~STEEL BOLT 'B'~~ **STEEL BOLT 'B'** set in conc/rock has been placed/found, bearing **270°**, **0.173m** from Mast/Plug/Pillar
7. ~~A~~ **A** set in conc/rock has been placed/found, bearing **0°**, **0.173m** from Mast/Plug/Pillar
8. Action required: **None**

Mark	Direction	Horiz. Distance	Height Difference	Mark	Direction	Horiz. Distance	Height Difference
TOWNSEND G.S.	359° 59' 60"		above standpt.	TOWNSEND G.S.	359° 59' 60"		above standpt.
BOLT 'A' IN ROCK	53° 23' 40"	1.222m	above standpt.	BOLT 'B' IN ROCK	02° 36'	3.892m	above standpt.
PILOT G.S.	195° 36' 52"		above standpt.	PILOT G.S.	24° 41' 00"	3.788m	above standpt.
RAMSHEAD G.S.	205° 10' 54"		above standpt.	BOLT 'A' IN ROCK	31° 53' 30"	4.967m	above standpt.
BOLT IN CONCRETE	204° 41' 10"	3.791m	above standpt.	PILOT G.S.	195° 36' 52"		above standpt.
BOLT 'B' IN ROCK	287° 38' 10"	1.476m	above standpt.	RAMSHEAD G.S.	208° 09' 17"		above standpt.

STANDPOINT: **PILLAR SPIGOT** STANDPOINT: **BOLT IN CONC**

Prepared by: **A. WOODRUFF** Checked: **Noted on U.I.M. Card**


G

S# 2733-2 D. West, Government Printer Beacon Diagram: KOSCIUSKO PILLAR	STATION: KOSCIUSKO TS 2761	Owner's Name: Address: Phone: Current Occupant: Address: Phone: Access Report of <u>6.7.19</u> was found suitable/unavailable. <u>AG</u> ACCESS
Net to Scale		
This section to be completed by officer constructing pillar. Original station mark found/not found. Description of mark: Original beacon found/not found. Description of beacon: Height Top of Vanes to Top Mark m. Height of mark m. above G.L. Diameter of Vanes m. below rock/cont. Height of Cairn m. Original Beacon has/has not been destroyed by me.		
Date	Record of Station	
25-3-92	GPS observed at (P), 2A (P) not found	

MARCH 1995 | STATION KOOSCIUSKO T.S. (Pillar) 2761

Owners Name: National Parks and Wildlife Service; Current Occupant:
 Address: Sawpit Creek
 Kosciusko National Park

Access Proceed from Jindabyne to Mr. Reg Lemaire of the Waste Point Village.
 to obtain mast and vanes if necessary for observations.
 Continue along the road to the Sawpit Creek Ranger Station
 for the keys to any gates.
 Follow the road to Rawsons Pass Parking Area.
 NO VEHICAL PAST THIS PARKING AREA 30MINS WALK UP ROAD N.P.W.S.
 Four wheel drive is necessary to scale the bank at the far
 end of the parking area where the road continues to the top.

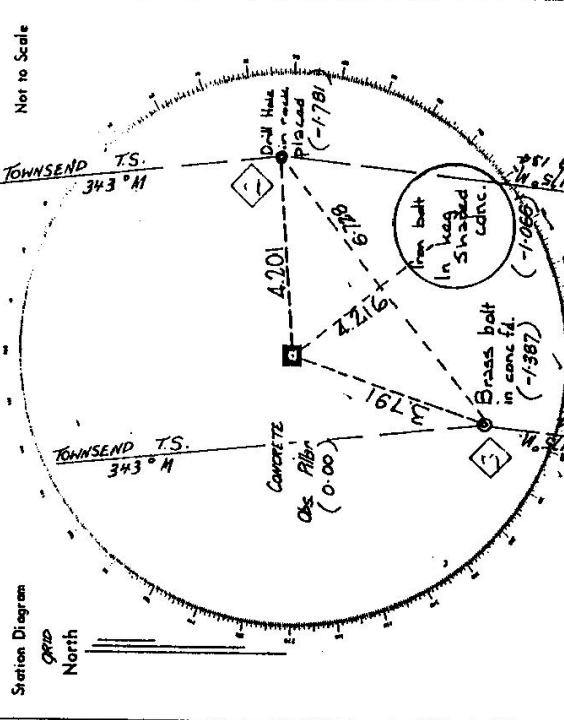

List of Observed Directions: -

Station	Direction	Station	Direction
S.P.A. Pillar T.S.	0.00.00	S.P.A. Pillar T.S.	0.00.00
Bole n Conc. T.S.	47.23.00	TOWNSEND T.S.	168.02.40
Concrete Pillar T.S.	78.15.00	Concrete Sawpit	192.42.00
TOWNSEND T.S.	167.52.59	Pillar Hole	227.25.00

Station	Direction	Station	Direction

KEY REQUIRED
 N.P.W.S. HIGH KEY
 30MINS NO LEAD
 Rawsons Pass
 Charlotte's Pass
 Kosciusko T. S. Pillar

JINDABYNE TO CHARLOTTE'S ABT 30 TO 40 MINS
 1995 WALK FROM RAWSONS PASS 30 MINS NO LEAD
 ALONG RD TO TOP.

Jindabyne
 Sawpit Creek
 Waste Point
 Rawsons Pass