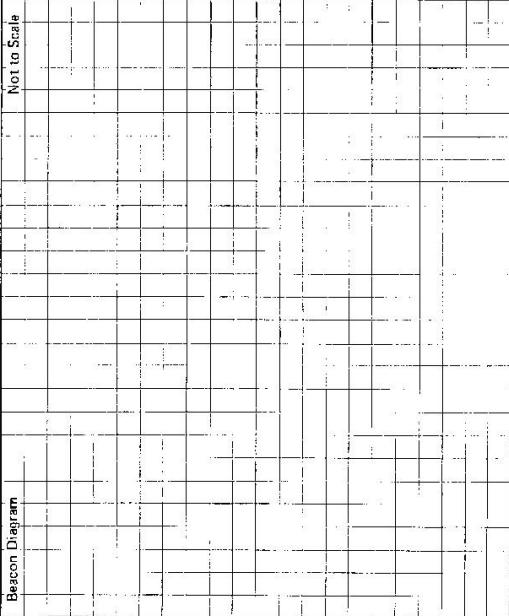


GS 24

STATION KRAWAREE IS 2764	Owner's Name: V.J. HAET * Address: "Fannie sign" Phone: Current Occupant: Address: Phone:
ACCESS	
Access Report of 17/10/1988 was found suitable/unsuitable.	
Beacon Diagram 	00.00 Bradwood PD Travelling south 00.44 Straight Ahead - Batemans Bay Rd on left. Follow signs to Moruya 02.65 Turn right - Sign "Captains Flat" 24.66 Turn right - Sign "Captains Flat" 24.68 Pass road to Captains Flat on right 30.81 Bridge over "Jerrabongula Cr" 31.05 Straight Ahead - Sign "Krawaree" 31.25 Turn right at sealed road across gnd "Drainage" 31.31 Take right fork 38.27 Turn left thru non gate "FERNLEIGH" 35.67 Small bridge * 39.21 Turn hard right onto track - (Straight ahead to owners house) 39.38 Turn left before gate - head up fence line. 39.86 Turn left - head towards gravel scrape at top of hill 40.01 Park truck at bottom of gravel scrape. I min walk to TRIG
This section to be completed by officer constructing pillar.	
Original station mark found/not found.	
Description of mark:	
Original beacon found/not found.	
Description of beacon:	
Height Top of Vane to Top Markm.	
Height of markm. above G.L. below	
Diameter of Vanem. Height of Cairnm.	
Original Beacon has/not been destroyed by me.	
Date	Record of Station