

GEODETTIC SURVEY OF NS&W

CENTRAL MAPPING AUTHORITY

GEODETTIC STATION RECONNAISSANCE and MAINTENANCE REPORT

Description:

1. Cleared by lanes bearing.....
 Note: Cross out word or words which do not apply
 from Trig. Mast

2. Mast & Vanes have been painted white & black respectively.

3. The station/pillar was unpiled/not unpiled/constructed on.....
 dimensions now being:

Description of mark..... should be explicit, e.g., S/Steel Pillar Plate, Steel plug, Brass plug, Bolt, G.I. Pipe

Height of mark.....
 above below rock/concrete; Mark is.....
 above below G.L.

Height of Top Vanes to Top Mark/Pillar plate.....
 Diameter of Vanes (vertical).....m.

Height of Cairn.....
 Diameter of Cairn.....
 Name Plate found/not found/placed.

Length of Mast.....
 (approximate if not unpiled)

4. A.....
 set in conc/rock has been placed/found, bearing.....
 °M from Mast/Plug/Pillar

5. A.....
 set in conc/rock has been placed/found, bearing.....
 °M from Mast/Plug/Pillar

6. A.....
 set in conc/rock has been placed/found, bearing.....
 °M from Mast/Plug/Pillar

7. A.....
 set in conc/rock has been placed/found, bearing.....
 °M from Mast/Plug/Pillar

8. Action required:.....

STANDPOINT:


STANDPOINT:

Mark	Direction	HORIZ. Distance	Height Difference	Mark	Direction	HORIZ. Distance	Height Difference
			above standpt				above standpt
			below standpt				below standpt
			above				above
			below				below
			above				above
			below				below
Prepared by: *[Signature]*

Checked: *[Signature]* Noted on U.T.M. Copy

Checked

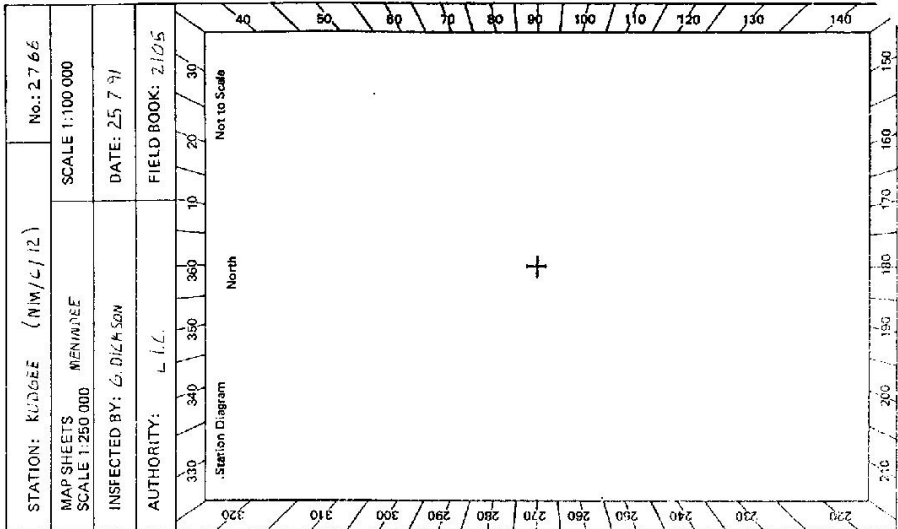

STATION: KUDGEE (NW/4/12)
 No.: 2766
 MAP SHEETS SCALE 1:250 000
 MENA/DFE
 INSPECTED BY: G. DILAKSON
 DATE: 25 7 91
 AUTHORITY: L.I.C.
 FIELD BOOK: 2105

SCALE 1:100 000
 DATE: 25 7 91
 FIELD BOOK: 2105

Not to Scale

Station Diagram

North

330 320 310 300 290 280 270 260 250 240 230 220

140 150 160 170 180 190 200 210 220 230 240 250 260 270 280 290 300 310 320 330

