

75-10

Department of Lands

Integral Survey of N.S.W.

RECONNAISSANCE and MAINTENANCE REPORT

STATION **KURNELL** (P) 2711

Co: _____ Ph: _____
 Map Sheet: _____ No: _____
 Inspected by: _____ Date: _____
 Authority: _____ Field Book: _____

Beacon Diagram Not to Scale

This Trig. Station has been: Note: Cross out word or words which do not apply

1. Completely cleared to permit 360° vision to surrounding Trigs.
2. Cleared by lanes bearing

from Trig. Mast

| STATION KURNELL | | R.L. | | ABSTRACT OF OBSERVATIONS | | | | | | |
|---|---------------|--------------------------|----------|--------------------------|------|---------------------------|----------|-------|----------|------|
| To | R.L. (metres) | Direction or Vert. Angle | Variance | Observer | Date | Dist. in metres at M.S.L. | Variance | Inst. | Observer | Date |
| SEES | | | | | | | | | | |
| S. Roundwood Res. | | 00 | R.O. | | | | | | | |
| Cornwall, E.L. Res. | | | | | | | | | | |
| Southwood Res. | | | | | | | | | | |
| Southland Res. | | | | | | | | | | |
| Canary Res. | | 270 | | | | | | | | |
| Banksia Res. | | 275 | | | | | | | | |
| Ashtfield Res. | | 301 | | | | | | | | |
| Hessitt Res. | | 311 | | | | | | | | |
| City (A.M.P.) | | 333 | | | | | | | | |
| CLEAR OF LOCAL OBSTRUCTION. BUT MAY BE OBLSCURED BY SMOG. | | | | | | | | | | |
| All directions Corrected to centre All Vert's corrected ground to ground SEE REAR OF CARD FOR REMARKS | | | | | | | | | | |

13. Diff. Ht. is m. above below

14. Diff. Ht. is m. above below

15. Diff. Ht. is m. above below

16. Diff. Ht. is m. above below

Prepared by: _____ Checked: _____


Date: _____ Record of Station

STATION **KURNELL IS 2771**

Owners Name.....
 Address.....
 Access.....


Current Occupant.....
 Address.....

Not to Scale

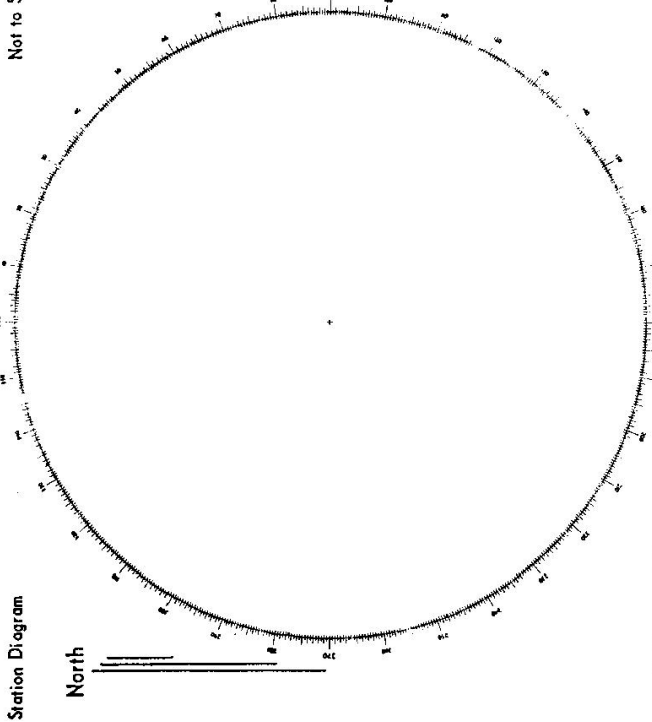

List of Observed Directions:-

| Standpoint: | | Standpoint: | |
|-------------|-----------|-------------|-----------|
| Station | Direction | Station | Direction |
| | | | |
| | | | |
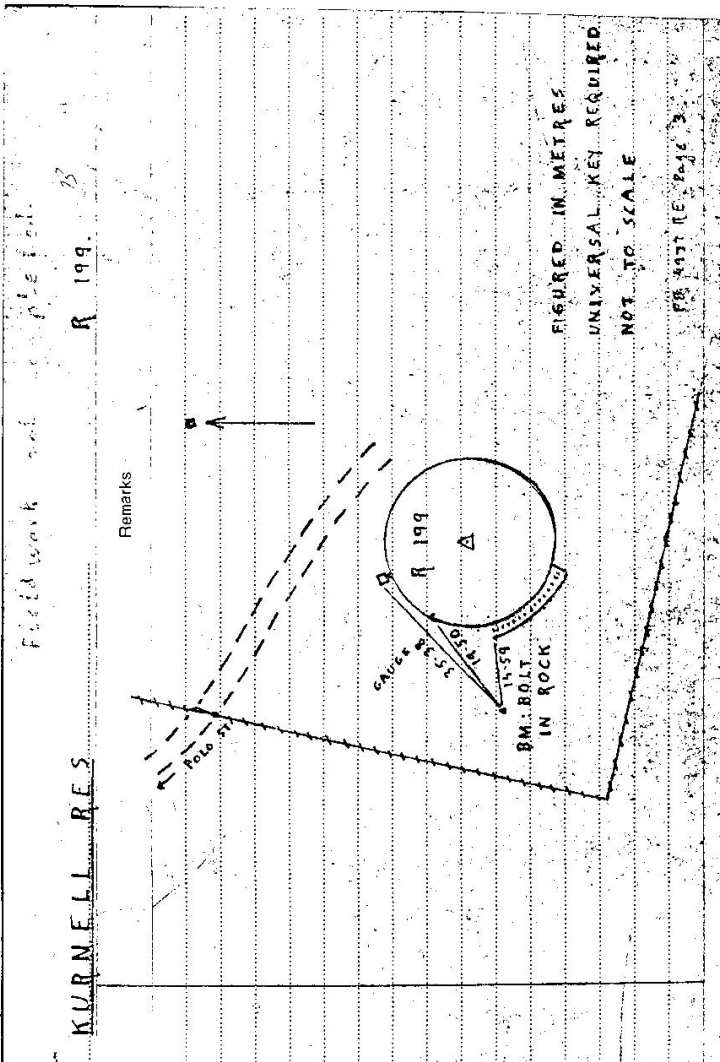

Remarks