

## GEODETTIC SURVEY OF M.S.W.

## CENTRAL MAPPING AUTHORITY

## GEODETTIC STATION RECONNAISSANCE and MAINTENANCE REPORT

## Description:

1. Cleared by ~~lenses-bearing~~..... Note: Cross out word or words which do not apply from Trig. Mast

2. Mast & Vanes have been painted white & black respectively- 11/10/78

3. The station ~~which was unpainted not unpainted~~ constructed on 11/10/78 dimensions now being-  
Description of mark ~~Red brick up rod (disturbed)~~ ~~Steel Plug, Brass Plug, Bolt, G.L. Pipe~~  
Height of mark ~~Not 80m~~ ~~above rock/concrete~~ Mark is .....m. above G.L.

Height of Top Vanes to Top Mark/Pillar plate .....m. Diameter of Vanes (vertical) .....m.

Height of Cairn .....m. Diameter of Cairn .....m. Name Plate found/not found/placed.

Length of Mast .....m. (approximate if not unplied)

4. A ..... set in conc/rock has been placed/found, bearing .....°M from Mast/Plug/Pillar

5. A ..... set in conc/rock has been placed/found, bearing .....°M from Mast/Plug/Pillar

6. A ..... set in conc/rock has been placed/found, bearing .....°M from Mast/Plug/Pillar

7. A ..... set in conc/rock has been placed/found, bearing .....°M from Mast/Plug/Pillar

8. Action required: .....

## STANDPOINT:

## STANDPOINT:

Mark	Direction	Horiz. Distance	Height Difference	Mark	Direction	Horiz. Distance	Height Difference
			above standpt.				above standpt.
			below standpt.				below standpt.
			above standpt.				above standpt.
			below standpt.				below standpt.
Prepared by: *g.ghani*

15/11/78

Checked: 16/11/78

Noted on U.T.M. Card

S: 2733-1

STATION: KYALITE

TS 2772  
No.: E410MAP SHEET  
SCALE 1:250 000


BALRANALD

INSPECTED BY: J. SHERWIN

DATE: 11/10/78

AUTHORITY:

FIELD BOOK:

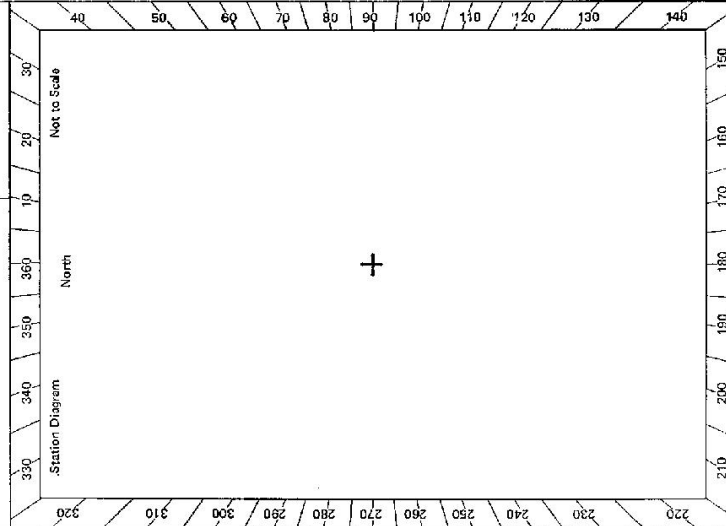

Checked