

CENTRAL MAPPING AUTHORITY

GEODETIC SURVEY OF A.S.W.

GEODETIC STATION RECONNAISSANCE and MAINTENANCE REPORT

Description:

1. Cleared by lanes bearing.....  
 Note: Cross out word or words which do not apply
2. Mast & Vanes have been painted white & black respectively. ✓  
 from Trig, Mast
3. The station/pillar was unpiled/not unpiled/constructed on 2.8 - 1.0 80, dimensions now being:  
 Description of mark: S/S P.M. should be explicit, e.g., S/Steel Pillar Plate, Steel plug, Brass plug, Bolt, G.I. Pipe  
 Height of mark.....m, above below rock/concrete; Mark is.....m, above below G.L.  
 Height of Top Vanes to Top Mark/Pillar plate.....m. Diameter of Vanes (vertical) 0.91 m.  
 Height of Cairn.....m. Diameter of Cairn.....m. Name Plate found/not found/placed.  
 Length of Mast 3.070 m. (approximate if not unpiled)

4. A..... set in conc/rock has been placed/found, bearing.....° M from Mast/Plug/Pillar
5. A..... set in conc/rock has been placed/found, bearing.....° M from Mast/Plug/Pillar
6. A..... set in conc/rock has been placed/found, bearing.....° M from Mast/Plug/Pillar
7. A..... set in conc/rock has been placed/found, bearing.....° M from Mast/Plug/Pillar

8. Action required:.....

STANDPOINT:


Mark	Direction	Horiz. Distance	Height Difference	Mark	Direction	Horiz. Distance	Height Difference
			above standpt.				above standpt.
			below				below
			above standpt.				above standpt.
			below				below
Prepared by:

Checked:

Noted on U.T.M. Card

Sr 2733-1

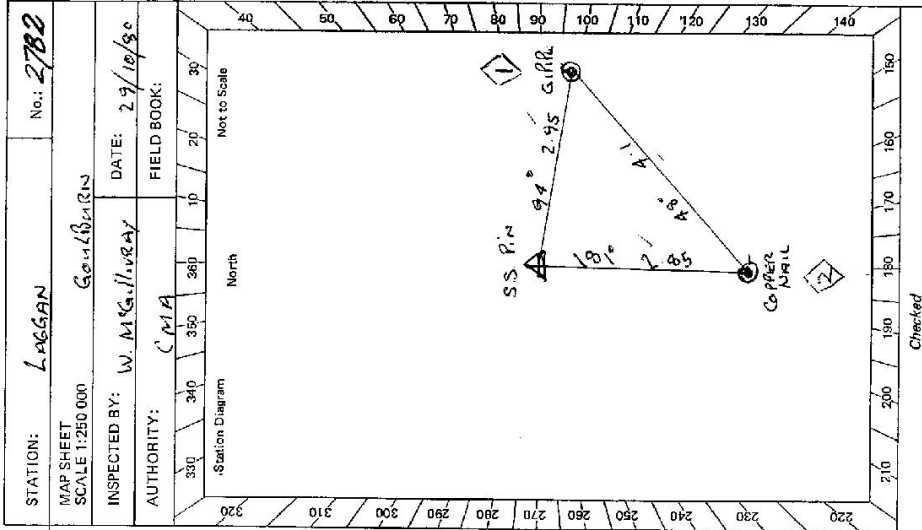


Checked

STATION: Laggan No: 2782

MAP SHEET SCALE 1:250 000

INSPECTED BY: W. McGovern DATE: 29/10/80

AUTHORITY: CMA FIELD BOOK:

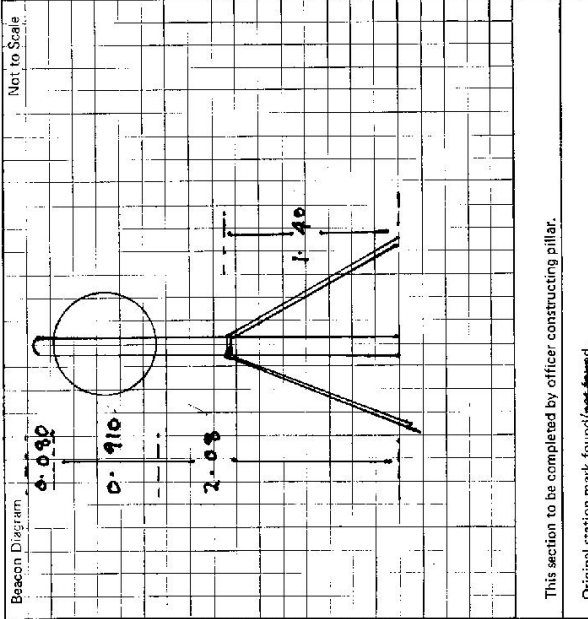STATION <b>LAGGAN GS IS 2782</b>	Owner's Name: ..... Address: ..... Phone: ..... Current Occupant: ..... Address: ..... Phone: ..... Access Report of <b>27/19/20</b> was found suitable/ <del>unsuitable</del> . ACCESS
Beacon Diagram Not to Scale 	This section to be completed by officer constructing pillar. Original station mark found/ <del>not found</del> . Description of mark: <b>S/S PIN</b> Original beacon found/ <del>not found</del> . Description of beacon: <b>STEEL TRIPOD</b> Height Top of Vanes to Top Mark ..... m. Height of mark ..... m. above G.L. ..... m. below G.L. Diameter of Vanes <b>0.910</b> m. Height of Cairn ..... m. Original Beacon has/has not been destroyed by me.
Date	Record of Station

STATION: <b>LAGGAN</b>	No.: <b>2782</b>
MAP SHEET SCALE 1:250 000 <b>GOULBURN S1 55/12</b>	
INSPECTED BY: <b>PCARR</b>	DATE: <b>9.12.80</b>
AUTHORITY: <b>CMA</b> FIELD BOOK: <b>445/10</b>	

Station Diagram

Description:

1. Cleared by lanes bearing... *Note: Cross out word or words which do not apply*  
 288° M - 30° M - 338° M - 66° M  
 188° M - 282° M - 242° M - 258° M - 272° M - 77° M, from Trig. Mast

2. Mast & Vanes have been painted white & black respectively.

3. The station/pillar was unpiled/not unpiled/constructed on.....19....., dimensions now being:

Description of mark: **S/S PIN**..... should be explicit, e.g. S/Steel Pillar Plate, Steel plug, Brass plug, Bolt, G.I. Pipe

Height of mark: **0.035** m. above/below rock/concrete; Mark is.....m. above/below G.L.

Height of Top Vanes to Top Mark/Pillar plate: **3.020** m. Diameter of Vanes (vertical).....m.

Height of Cairn.....m. Diameter of Cairn.....m. Name Plate found/hot found/placed.

Length of Mast.....**3.100** m. (approximate if not unpiled)

4. A.....**G.I. PIPE**..... set in conc/rock has been placed/feared, bearing...**141**° M from Mast/Plug/Pillar

5. A.....**Cu Nail**..... set in conc/rock has been placed/feared, bearing...**183**° M from Mast/Plug/Pillar

6. A..... set in conc/rock has been placed/feared, bearing.....° M from Mast/Plug/Pillar

7. A..... set in conc/rock has been placed/feared, bearing.....° M from Mast/Plug/Pillar

8. Action required:.....

STANDPOINT: **S/S pin 2782-0** ✓

STANDPOINT: **Cu Nail in Conc 2782-2** ✓

Mark	Direction	Horiz. Distance	Height Difference	Mark	Direction	Horiz. Distance	Height Difference
Macalister 2782-0	0 00 00		above standpt.	Macalister 2782-0	0 00 00		above standpt.
Redbank 3867-0	15 18 285		below	Redbank 3867-0	15 17 50		below standpt.
G.I. Pipe 2782-1	0 11	2.998	above standpt.	S/S Pin 2782-0	268.43	2.890	below standpt.
Cu Nail 2782-2	88 42	2.890	below	G.I. Pipe 2782-1	315 31	4.103	below standpt.
			above standpt.				above standpt.
			below				below
			above standpt.				above standpt.
			below				below
			above standpt.				above standpt.
			below				below

Prepared by: **J. SHERWIN** 24-7-81

Checked: **Sheet 24-2-81**

Noted on U.I.M. Card

Checked

GS

<p>2723-2 D. West, Government Printer Beacon Diagram</p>	<p>STATION <b>LAGGAN 2782</b></p>	<p>Owner's Name: .....                  Address: .....                  Phone: .....</p> <p>Current Occupant: .....                  Address: .....                  Phone: .....</p> <p>ACCESS <b>9-12-1980</b>                  Access Report of ...../1912 was found suitable/unsuitable.</p>
<p>Not to Scale</p>		<p>Date</p> <p>Record of Station</p>
<p>This section to be completed by officer constructing pillar.</p> <p>Original station mark found/not found.</p> <p>Description of mark: .....</p> <p>Original beacon found/not found.</p> <p>Description of beacon: .....</p> <p>Height Top of Vanes to Top Mark.....m.</p> <p>Height of mark.....m. above G.L. below rock/conc.....m. below</p> <p>Diameter of Vanes.....m. Height of Cairn.....m.</p> <p>Original Beacon has/has not been destroyed by me.</p>		

**LAND INFORMATION CENTRE**

GEODETTIC SURVEY OF N.S.W.

**GEODETTIC STATION RECONNAISSANCE and MAINTENANCE REPORT**

Description:

*Note: Cross out words or words which do not apply*

1. Cleared by lanes bearing..... from Trig. Mast.
2. Mast & Vanes have been painted white & black respectively.
3. The station/pillar was unpiled/not unpiled/constructed on..... 19....., dimensions now being: Description of mark..... should be explicit, e.g., S/Steel Pillar Plate, Steel plug, Brass plug, Bolt, G.I. Pipe Height of mark..... m. above below rock/concrete; Mark is..... m. above below G.L.
- Height of Top Vanes to Top Mark/Pillar plate..... m. Diameter of Vanes (vertical)..... m.
- Height of Cairn..... m. Diameter of Cairn..... m. Name Plate found/not found/placed.
- Length of Mast..... m. (approximate if not unplied)
4. A..... set in conc./rock has been placed/ found, bearing..... M from Mast/Plug/Pillar
5. A..... set in conc./rock has been placed/ found, bearing..... M from Mast/Plug/Pillar
6. A..... set in conc./rock has been placed/ found, bearing..... M from Mast/Plug/Pillar
7. A..... set in conc./rock has been placed/ found, bearing..... M from Mast/Plug/Pillar
8. Action required.....

STATION: **LAGGAN GS.** TS No.: **2782**  
 MAP SHEET SCALE 1:250 000  
 INSPECTED BY: **G. Ford** DATE: **31/1/91**  
 AUTHORITY: **L.I.C.** FIELD BOOK: **2103**

STANDPOINT:				STANDPOINT:			
Mark	Direction	Horiz. Distance	Height Difference	Mark	Direction	Horiz. Distance	Height Difference
			above standpt.				above standpt.
			below standpt.				below standpt.
			above standpt.				above standpt.
			below standpt.				below standpt.
Inspected by: **J.D. 6/2/91** Checked: **[Signature]** Known as: **U.T.M. Corp.**

