

CENTRAL MAPPING AUTHORITY

GEODETTIC SURVEY OF N.S.W.

GEODETTIC STATION RECONNAISSANCE and MAINTENANCE REPORT

STATION: Lake Barnhurst T1 No.: 2785
 MAP SHEET SCALE 1:250 000
 INSPECTED BY: M.L. Morrison DATE: 18/10/78
 AUTHORITY: CMAA FIELD BOOK: 1710

Station Diagram

Not to Scale

Description: Cleared by vanes bearing 360° Note: Cross out word or words which do not apply

1. Cleared by vanes bearing 360° from Trig. Mast
2. Mast & Vanes have been painted white & black respectively, ✓
3. The station/~~marker~~ ~~is not unspiled~~ /not unspiled/~~constructed~~ on 18/10/1978, dimensions now being:
 - Description of mark.....should be explicit, e.g., S/Steel Pillar Plate, Steel plug, Brass plug, Bolt, G.I. Pipe
 - Height of mark.....m. above below Mark is.....m. above below G.L.
 - Height of Top Vanes to Top Mark/Pillar plate.....m. Diameter of Vanes (vertical).....m.
 - Height of Cairn.....m. Diameter of Cairn.....m. Name Plate found/not found/~~placed~~.
 - Length of Mast.....m. (approximate if not unspiled)
4. A.....set in conc./rock has been placed/found, bearing.....° M from Mast/Plug/Pillar
5. A.....set in conc./rock has been placed/found, bearing.....° M from Mast/Plug/Pillar
6. A.....set in conc./rock has been placed/found, bearing.....° M from Mast/Plug/Pillar
7. A.....set in conc./rock has been placed/found, bearing.....° M from Mast/Plug/Pillar
8. Action required:.....


STANDPOINT:				STANDPOINT:			
Mark	Direction	Horiz. Distance	Height Difference	Mark	Direction	Horiz. Distance	Height Difference
			above standpt.				above standpt.
			below				below
			above standpt.				above standpt.
			below				below
Trig. set in fair condition.
 Mast and vanes were painted by me.
 No other marks fld. Good clear
 360° vision, no clearing required

Prepared by: [Signature] Checked: [Signature]

Noted on U.T.M. Card

Sr: 2733-2 D. West, Government Printer

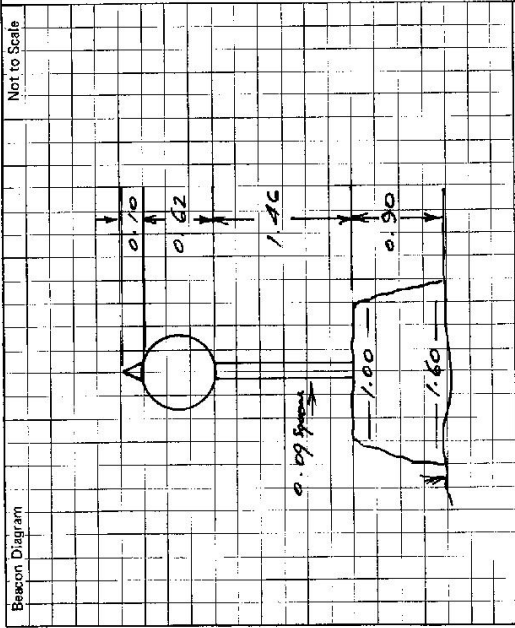

This section to be completed by officer constructing pillar.

Original station mark found/not found.

Description of mark:

Original beacon found/not found.

Description of beacon:

Height: Top of Vanes to Top Mark.....m.

Height of mark.....m. above G.L. below

Diameter of Vanesm. Height of Cairnm.

Original Beacon has/has not been destroyed by me.

STATION LAKE BATHURST G.S. 2785 TS	Owner's Name: Address: Phone: Current Occupant: Address: Phone: ACCESS Access Report of 18/10/1978 was found suitable/unsuitable.
Km Direction 0.00 At Lake Bathurst Hotel Trough. Take road to Mayfield 21, Bynona 29, Charleyong 37. 3.55 Pass road to Charleyong 33, Mayfield 17 on your right. 4.80 Pass Cullulla Rd on right 6.95 Turn left over ramp at old mail box 8.20 Turn left through double iron gate, follow track towards yards 8.30 Follow track around to the right. 8.55 GATE. Head to top of ridge where the trap can be seen. 9.20 Pass through down fence. 9.50 Lake Bathurst G.S.	Date Record of Station

GEODETTIC SURVEY OF NS/SK

CENTRAL MAPPING AUTHORITY

GEODETTIC STATION RECONNAISSANCE and MAINTENANCE REPORT

- Description:
1. Cleared by James bearing *360°* Note: Cross out word or words which do not apply from Trig. Mast
 2. Mast & Vanes have been painted white & black respectively. in pairs of rocks found
 3. The station/pillar was unpiled/not unpiled/constructed on.....19....., dimensions now being: Description of mark.....should be explicit, e.g., S/Steel Pillar Plate, Steel plug, Brass plug, Bolt, G.I. Pipe Height of mark.....m. above below rock/concrete; Mark is.....m. above below G.I. Height of Top Vanes to Top Mark/Pillar platem. Diameter of Vanes (vertical).....m. Height of Cairn.....m. Diameter of Cairn.....m. Name Plate found/not found/placed. Length of Mastm. (approximate if not unpiled)
 4. A.....set in conc/rock has been placed/found, bearing.....°M from Mast/Plug/Pillar
 5. A.....set in conc/rock has been placed/found, bearing.....°M from Mast/Plug/Pillar
 6. A.....set in conc/rock has been placed/found, bearing.....°M from Mast/Plug/Pillar
 7. A.....set in conc/rock has been placed/found, bearing.....°M from Mast/Plug/Pillar
 8. Action required: *No action required*

STANDPOINT:

Mark	Direction	Horiz. Distance	Height: Difference	Mark	Direction	Horiz. Distance	Height: Difference
			above standpt.				above standpt.
			below				below
			above standpt.				above standpt.
			below				below
Prepared by: *Rik Barrota 14/5/22* Checked:

S:2785-1

Noted on U.T.M. Card

Checked

STATION: LAKE BATHURST No.: 2785
 MAP SHEET SCALE 1:250 000
 INSPECTED BY: Rik Barrota DATE: April 19
 AUTHORITY: CMA FIELD BOOK:

Station Diagram
 North
 Not to Scale

G

SI-2733-2 D. Wert, Government Printer

Beacon Diagram	Not to Scale	STATION <u>Lake Bathurst TS 2785</u>
<p>Owner's Name:</p> <p>Address:</p> <p>Phone:</p> <p>Current Occupant:</p> <p>Address:</p> <p>Phone:</p>		
<p>Access Report of <u>April 25th</u> <u>ACCESS</u></p> <p><u>April 1971</u> was found suitable/unsuitable.</p> <p><u>Refer Lake Bathurst 1-25000 Sheet</u></p> <p><u>Approach from "Ketherwood" Property.</u></p> <p><u>20 min walk to the station</u></p>		
<p>This section to be completed by officer constructing pillar.</p> <p>Original station mark found/not found.</p> <p>Description of mark:</p> <p>Original beacon found/not found.</p> <p>Description of beacon:</p> <p>Height Top of Vanes to Top Mark.....m.</p> <p>Height of mark.....m. above G.L. below</p> <p>Diameter of Vanes.....m. Height of Cairn.....m.</p> <p>Original Beacon has/has not been destroyed by mm.</p>		
		Date
		Record of Station