


STATION Lambir (P) TS 2788


Owners Name.....
Current Occupant.....

Address.....
Address.....

Access Sept 1974

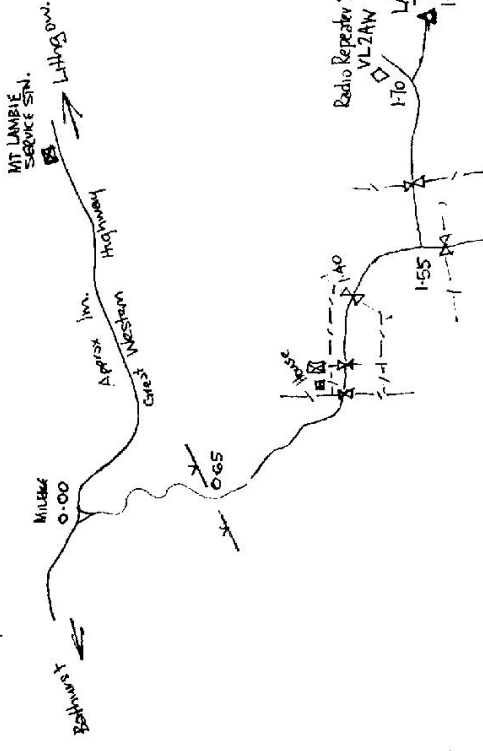

D. West, Government Printer, New South Wales - 1976

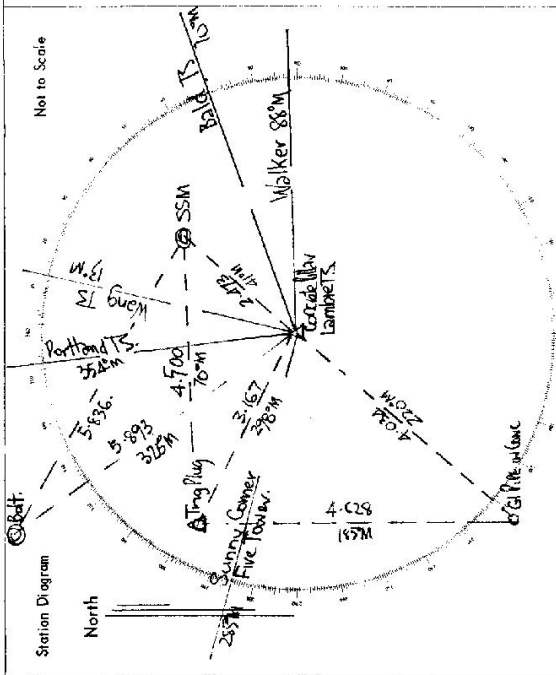

List of Observed Directions:-

Standpoint: Conc Pillar		Standpoint: Trig Plug	
Station	Direction	Station	Direction
Portland T.S. (P)	307° 07' 60"	Lambir T.S. Pillar	307° 07' 60"
Walker T.S.	12° 26' 48.6"	G.P. P	153° 26' 12.5"
Walker T.S.	81° 21' 34.2"	SSM	230° 49' 36.5"
Sunny Corner Five Tower	309° 01' 09.5"		308° 00' 45.5"
Conc Pillar		SSM	
Station	Direction	Station	Direction
Bald T.S.	259° 57' 60"	Bald T.S.	307° 07' 60"
G.P. P	149° 10' 39.5"	Lambir Pillar	153° 26' 12.5"
Trig Plug (Lambir)	228° 10' 04"	Bolt	230° 28' 47.4"
Bolt	256° 49' 05.5"	Portland T.S. (P)	287° 52' 37.5"
Portland T.S. (P)	267° 03' 14.4"		
SSM	338° 27' 34.4"		

LAND INFORMATION CENTRE

GEODETTIC SURVEY OF A.S.W.

GEODETTIC STATION RECONNAISSANCE and MAINTENANCE REPORT

STATION: LAMBIE (P) No.: 2788

Description: *Note: Cross out word or words which do not apply*

1. Cleared by lanes bearing: All Annex CLEAR from Trig. Mast

2. Mast & Vanes have been painted white & black respectively. ✓

3. The station/pillar was unplied/not unplied/constructed on..... 19....., dimensions now being:

Description of mark..... should be explicit, e.g., S/Steel Pillar Plate, Steel plug, Brass plug, Bolt, G.I. Pipe

Height of mark..... m. ^{above} rock/concrete; Mark is..... m. ^{above} G.L.

Height of Top Vanes to Top Mark/Pillar plate..... m. Diameter of Vanes (vertical)..... m.

Height of Cairn..... m. Diameter of Cairn..... m. Name Plate found/not found/placed.

Length of Mast..... m. (approximate if not unplied)

- 4. A..... set in conc/rock has been placed/found, bearing..... °M from Mast/Plug/Pillar
- 5. A..... set in conc/rock has been placed/found, bearing..... °M from Mast/Plug/Pillar
- 6. A..... set in conc/rock has been placed/found, bearing..... °M from Mast/Plug/Pillar
- 7. A..... set in conc/rock has been placed/found, bearing..... °M from Mast/Plug/Pillar
- 8. Action required: N/A

STANDPOINT:				STANDPOINT:			
Mark	Direction	Horiz. Distance	Height Difference	Mark	Direction	Horiz. Distance	Height Difference
			above standpt.				above standpt.
			below standpt.				below standpt.
			above standpt.				above standpt.
			below standpt.				below standpt.
Prepared by: SLD 27/04/97

Checked:

Noted on U.T.M. Card

Checked

