



STATION Largs L.S. T.S. 2803

Current Occupant.....

Address.....

Owners Name.....


Address.....

Access.....

Not to Scale


Station Diagram

North

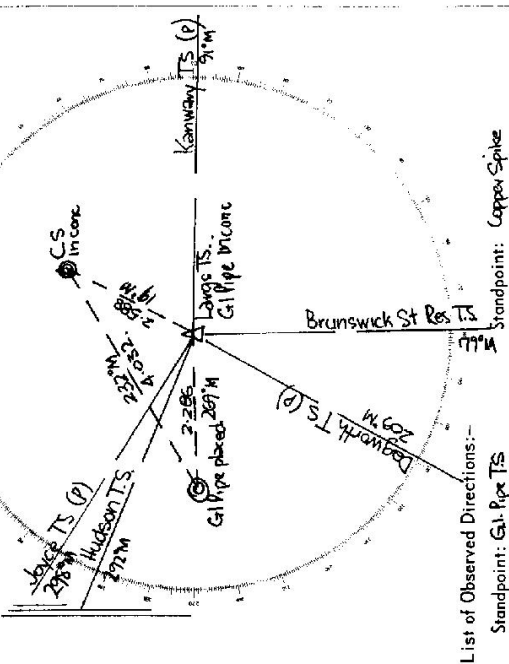

List of Observed Directions:-

Station	Direction	Station	Direction
Loyce T.S. (P)	339° 59' 60"	Loyce T.S. (P)	339° 59' 60"
Kanneway T.S. (P)	152° 53' 16.8"	Largs T.S. Gil P	20° 18' 39.5"
Brunswick St Res.	240° 46' 42.7"	Dagworth T.S. (P)	210° 51' 33.5"
Dagworth T.S. (P)	210° 50' 12.6"	Gil. Pipe Placed	278° 07' 34.0"
Hudson T.S.	354° 19' 58.9"		
G.I. Pipe T.S.			
Station	Direction	Station	Direction
Loyce T.S. (P)	339° 59' 60"		
Cannon Spike	80° 10' 43"		
Dagworth T.S. (P)	210° 50' 12.6"		
Gil. Pipe placed	278° 07' 34.0"		

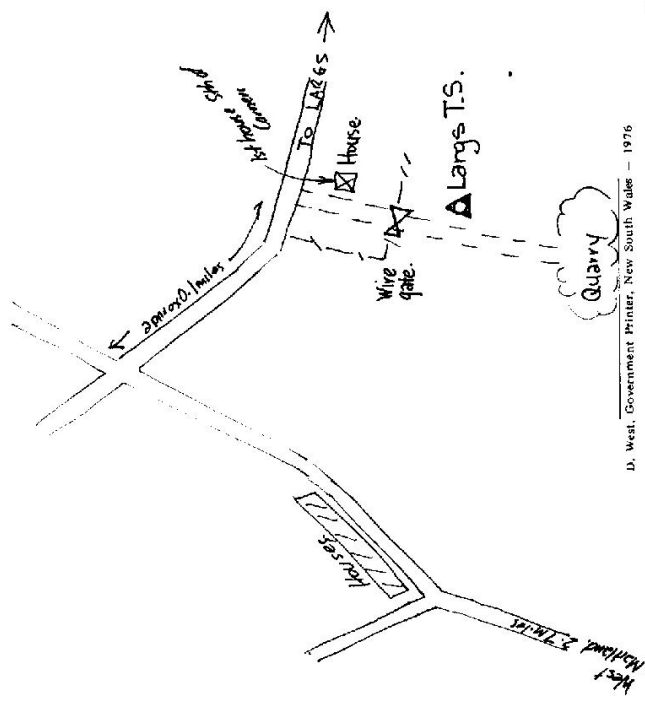

D. West, Government Printer, New South Wales - 1976