

GEODETTIC SURVEY OF N.S.W.

CENTRAL MAPPING AUTHORITY


GEODETTIC STATION RECONNAISSANCE and MAINTENANCE REPORT

STATION: *Larmer* No.: *2809*

MAP SHEET SCALE 1:250 000 *CANBERRA*

INSPECTED BY: *P. K. Barnola* DATE: *May 70*

AUTHORITY: *C.M.A* FIELD BOOK:

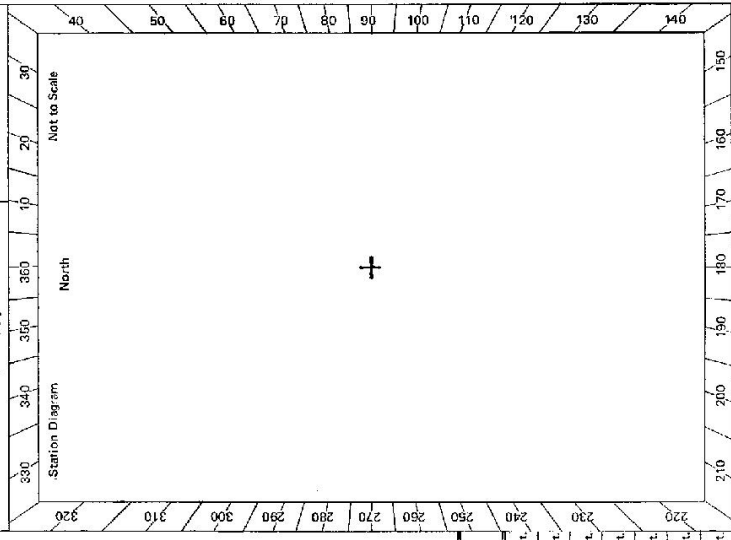

- Description: *Note: Cross out word or words which do not apply*
1. Cleared by Janes bearing..... from Trig, Mast
  2. Mast & Vanes have been painted white & black respectively.
  3. The station/pillar was unpiled/not unpiled/constructed on..... 19..... dimensions now being: *Small hole in concrete in small pile of rocks found.*  
Description of mark.....should be explicit, eg, S/Steel Pillar Plate, Steel plug, Brass plug, Bolt, G.I. Pipe  
Height of mark.....m. <sup>above</sup> rock/concrete; Mark is.....m. <sup>above</sup> G.L.
  - Height of Top Vanes to Top Mark/Pillar plate .....m. Diameter of Vanes (vertical).....m.
  - Height of Cairn.....m. Diameter of Cairn.....m. Name Plate found/not found/placed.
  - Length of Mast .....m. (approximate if not unpiled)
  4. A.....set in conc/rock has been placed/found, bearing.....°M from Mast/Plug/Pillar
  5. A.....set in conc/rock has been placed/found, bearing.....°M from Mast/Plug/Pillar
  6. A.....set in conc/rock has been placed/found, bearing.....°M from Mast/Plug/Pillar
  7. A.....set in conc/rock has been placed/found, bearing.....°M from Mast/Plug/Pillar
  8. Action required:.....

STANDPOINT:				
Mark	Direction	HORIZ. Distance	Height Difference	Mark
			above standpt.	
			below standpt.	
			above standpt.	
			below standpt.	
Prepared by: *P. K. Barnola 14/6/72* Checked: *Checked*

Notes on U.T.M. Grid

Sr 2733 - 2 D. West, Government Printer

<p>STATION <b>LARMER</b> TS <b>2809</b></p> <p>Owner's Name: .....                  Address: .....                  Phone: .....</p> <p>Current Occupant: .....                  Address: .....                  Phone: .....</p> <p>ACCESS                  Access Report of <b>MAY 1979</b> was found suitable/suitable.</p> <p><b>Reke Boro and Dallen 125000 SHEEPS</b></p>		<p>Not to Scale</p>
<p>This section to be completed by officer constructing pillar.</p> <p>Original station mark found/not found.</p> <p>Description of mark: .....</p> <p>Original beacon found/not found.</p> <p>Description of beacon: .....</p> <p>Height Top of Vanes to Top Mark .....m.</p> <p>Height of mark .....m. above below G.L.</p> <p>.....m. below rock/cone.....m. below</p> <p>Diameter of Vanes .....m. Height of Cairn .....m.</p> <p>Original Beacon has/has not been destroyed by me.</p>		
		<p>Date</p> <p>Record of Station</p>