

GEODETTIC SURVEY OF N.S.K.

CENTRAL MAPPING AUTHORITY

GEODETTIC STATION RECONNAISSANCE and MAINTENANCE REPORT

STATION: LEAKFELTZ G.S. <sup>TS</sup> No.: 2821

MAP SHEET SCALE 1:250 000  
INSPECTED BY: M.L. MASON DATE: 2-11-78

AUTHORITY: C.M.A. FIELD BOOK: 1711

Description:  
1. Cleared by lanes bearing.....  
Note: Cross out word or words which do not apply from Trig. Mast

2. Mast & Vanes have been painted white & black respectively.

3. The station/pillar was unpiled/not unpiled/constructed on.....19....., dimensions now being:

Description of mark.....should be explicit, e.g., S/Steel Pillar Plate, Steel plug, Brass plug, Bolt, G.I. Pipe

Height of mark.....m. above below rock/concrete. Mark is.....m. above below G.L.

Height of Top Vanes to Top Mark/Pillar plate.....m. Diameter of Vanes (vertical).....m.

Height of Cairn.....m. Diameter of Cairn.....m. Name Plate found/not found/placed.

Length of Mast.....m. (approximate if not unpiled)

4. A.....set in conc/rock has been placed/found, bearing.....°M from Mast/Plug/Pillar

5. A.....set in conc/rock has been placed/found, bearing.....°M from Mast/Plug/Pillar

6. A.....set in conc/rock has been placed/found, bearing.....°M from Mast/Plug/Pillar


7. A.....set in conc/rock has been placed/found, bearing.....°M from Mast/Plug/Pillar

8. Action required:.....

STANDPOINT:

Mark	Direction	Horiz. Distance	Height Difference	Mark	Direction	Horiz. Distance	Height Difference
			above standpt				above standpt
			below standpt				below standpt
			above standpt				above standpt
			below standpt				below standpt
Prepared by: *[Signature]* 16/11/78  
Checked: *[Signature]* 16/11/78  
Noted on U.T.M. Card

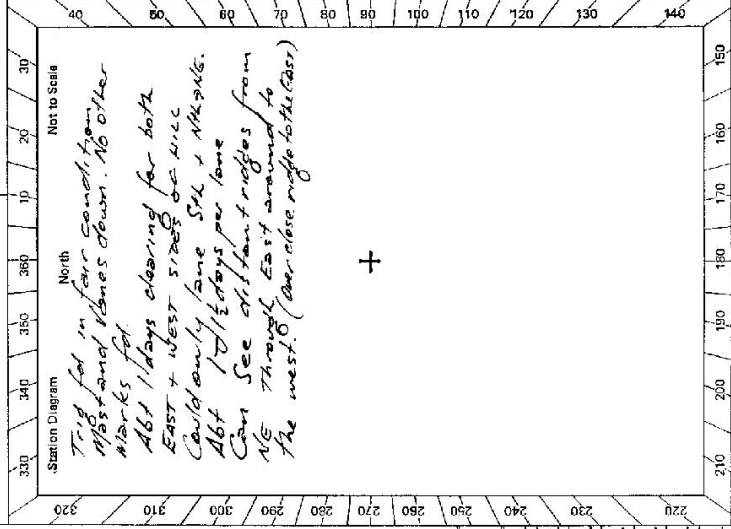


Checked

Sr 2733-2 D. West, Government Printer

GS 24

STATION LEAFFIELD G.S. TS 2821

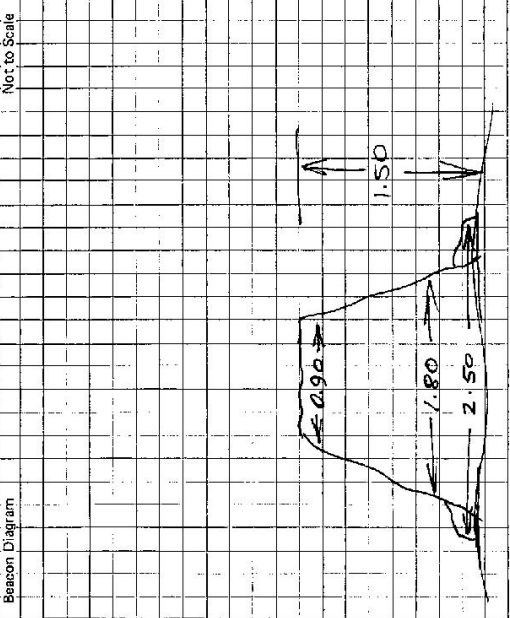

Owner's Name: L. E. D. M. GRAN  
 Address: WINDHELLAMA  
 Phone: .....

Current Occupant: .....


Address: .....

Phone: .....

ACCESS

Access Report of 21.11.19 was found suitable/unsuitable.

- Direction  
 Old Bongoma sheep. Head South towards Windhellama  
 Pass Tarago Rd 38' on RIGHT.  
 Turn left through gate follow fence line.  
 Gate + Creek crossing. Follow fence line  
 Gate. Follow track around to the right.  
 Take left fork  
 Clearing. Keep right make own way following map.  
 Park Truck 5 min. easy walk to Trig

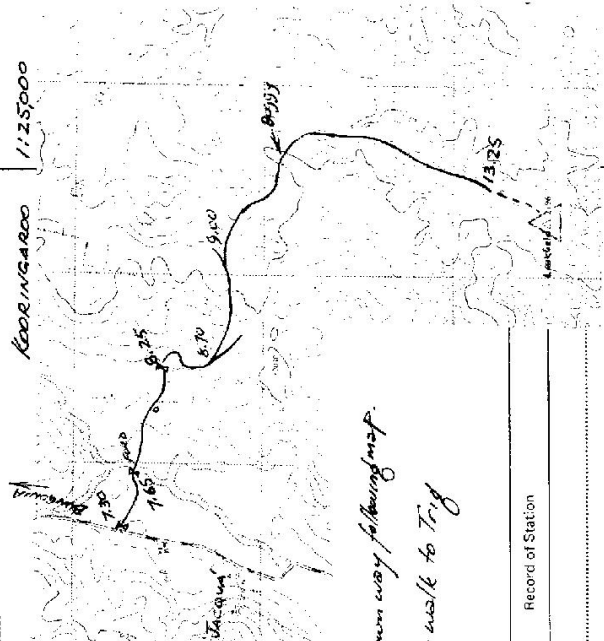

Date	Record of Station

This section to be completed by officer constructing pillar.

Original station mark found/not found. ....

Description of mark: .....

Original beacon found/not found. ....

Description of beacon: .....

Height Top of Vane to Top Mark ..... m.  
 above ..... m. below G.L.  
 Height of mark ..... m. above ..... m. below ..... m.

Diameter of Vane ..... m. Height of Cairn ..... m.

Original Beacon has/not been destroyed by me.


CENTRAL MAPPING AUTHORITY

STATION: LEAKFIELD No: 2821

MAP SHEET SCALE 1:250 000 660134RN

INSPECTED BY: R. ELLIS DATE: 9/9/81

AUTHORITY: C.M.A. FIELD BOOK: 0135

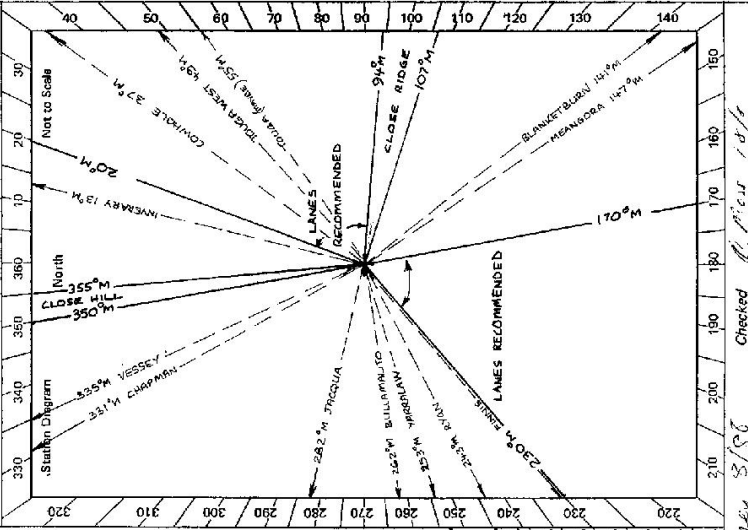

GEODETIC STATION RECONNAISSANCE and MAINTENANCE REPORT

- Description: *Note: Cross out word or words which do not apply*
1. Cleared by Jones-bearing *(C.M.A. FIELD BOOK)* from Trig. Mast
  2. Mast & Vanes have been painted white & black respectively.
  3. The station/pillar was emptied/not unpiled/constructed on *0.2/0.2/19.8/...*, dimensions now being: Description of mark *PLUG* should be explicit, e.g. S/Steel Pillar Plate, Steel plug, Brass plug, Bolt, G.I. Pipe  
Height of mark *1.5* above/below rock/concrete; Mark is *above* below G.L.  
Height of Top Vanes to Top Mark/Pillar plate *1.5* m. Diameter of Vanes (vertical) *1.5* m.  
Height of Cairn *1.5* m. Diameter of Cairn *2.0* m. Name Plate found/not found/placed.  
Length of Mast *1.5* m. (approximate if not unpiled)
  4. A *set in conc/rock has been placed/found, bearing: M from Mast/Plug/Pillar*
  5. A *set in conc/rock has been placed/found, bearing: M from Mast/Plug/Pillar*
  6. A *set in conc/rock has been placed/found, bearing: M from Mast/Plug/Pillar*
  7. A *set in conc/rock has been placed/found, bearing: M from Mast/Plug/Pillar*
  8. Action required: *VERY GOOD CONC. PILLAR SITE - GOOD VISIBILITY TO THE WEST.*

STANDPOINT:			
Mark	Direction	Horiz. Distance	Height Difference
			above standpt.
			below standpt.
			above standpt.
			below standpt.
Prepared by: *Ellis* 3/1/81 Checked: *Ellis* 3/1/81

GS 24

STATION LEAKFIELD TS 2821

Owner's Name: TR. ROBERTS  
 Address: (Still Current @ 5075)  
 Phone:

Current Occupant: MR. KOENIG  
 Address: "THE ACRES"  
 Phone: (048)

ACCESS 9-9-1981

Access Report of 2.1.1978 was found suitable/unavailable.

KM FENCELINE

0.0 OLD SCHOOL AT ALINGONIA ~ HEAD SOUTH TOWARDS WINDELLAMA .  
 4.25 PASS ROAD ON RIGHT ~ SIGN "TARAGO 30"  
 7.30 TURN LEFT THROUGH GATE ~ FOLLOW FENCELINE .  
 7.66 IRON GATE ~ CROSS CREEK .  
 8.23 IRON GATE  
 8.67 VEER RIGHT ~ FOLLOW TRACK UP HILL  
 9.00 PASS GATE ON RIGHT ~ FOLLOW TRACK TO LEFT KEEPING FENCE ON RIGHT .  
 9.24 FENCE CORNER ~ TURN RIGHT  
 9.55 PASS THROUGH WIRE GATE AND TURN LEFT ~ FOLLOW FENCE ON LEFT .  
 9.64 TURN RIGHT ~ FOLLOW PAINT TRACK .  
 9.81 PASS IN FRONT OF DAM ~ KEEP DAM ON LEFT .  
 9.87 HEAD UP RIDGE ~ TURN LEFT AT TOP AND FOLLOW NORTH FOR 200 METERS .  
 10.12 TURN RIGHT OFF RIDGE AND CROSS CREEK ~ HEAD IN RE DIRECTION THEN MAKE OWN WAY UP RIDGE .  
 10.7 TOP OF RIDGE ~ TURN RIGHT AND FOLLOW RIDGE SOUTH .  
 11.14 PASS OVER OLD FENCE .  
 11.54 STOP AT NARROW PART OF RIDGE ~ 5 MINUTES EASY WALK TO TRIG .  
 WITH 1-2 HRS CLEARING VEHICLES COULD BE DRIVEN TO TRIG .

Not to Scale

Beacon Diagram

CAIRN IN GOOD CONDITION  
 POLE & DISCS IN CHAIRS

GROUND SURFACE IS BROKEN ROCK  
 GOOD CONC PILLAR SITE  
 CLEARING AND LAMING WOULD TAKE 2-3 DAYS

This section to be completed by officer constructing pillar.

Original station mark found/not found.

Description of mark: .....

Original beacon found/not found.

Description of beacon: .....

Height Top of Vane to Top Mark.....m.  
 above below G.L.  
 Height of mark.....m. above below  
 Diameter of Vane.....m. Height of Cairn.....m.  
 Original Beacon has/has not been destroyed by me.

Date	Record of Station