

GEODETIC SURVEY OF NSW

CENTRAL MAPPING AUTHORITY

GEODETIC STATION RECONNAISSANCE and MAINTENANCE REPORT


STATION: LEE No.: 2828

MAP SHEET SCALE 1:250 000 CANBERRA

INSPECTED BY: G. C. HANNA DATE: 16/05/1978

AUTHORITY: FIELD BOOK:

- Description:
1. Cleared by lanes bearing. *Note: Cross out word or words which do not apply*
 2. Mast & Vanes have been painted white & black respectively.
 3. The station/pillar was unpiled/not unpiled/constructed on 19 dimensions now being:
 - Description of mark should be explicit, e.g., S/Steel Pillar Plate, Steel plug, Brass plug, Bolt, G.I. Pipe
 - Height of mark m. ^{above}/_{below} rock/concrete; Mark is ^{above}/_{below} G.L.
 - Height of Top Vanes to Top Mark/Pillar plate m. Diameter of Vanes (vertical) m.
 - Height of Cairn m. Diameter of Cairn m. Name Plate found/not found/placed.
 - Length of Mast m. *appropriate if not unpiled*
 4. A set in conc./rock has been placed/found, bearing ° M from Mast/Plug/Pillar
 5. A set in conc./rock has been placed/found, bearing ° M from Mast/Plug/Pillar
 6. A set in conc./rock has been placed/found, bearing ° M from Mast/Plug/Pillar
 7. A set in conc./rock has been placed/found, bearing ° M from Mast/Plug/Pillar
 8. Action required:

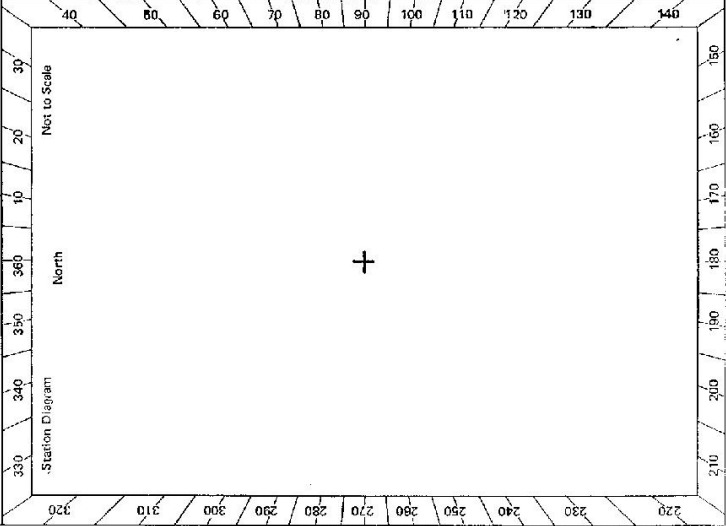

STANDPOINT:


Mark	Direction	Horiz. Distance	Height Difference	Mark	Direction	Horiz. Distance	Height Difference
			above standpt.				above standpt.
			below standpt.				below standpt.
			above standpt.				above standpt.
			below standpt.				below standpt.
Prepared by: G. Hanna Checked: Noted on U.T.M. Carr

S: 2738-2 D. West Government Printer

Beacon Diagram

Not to Scale

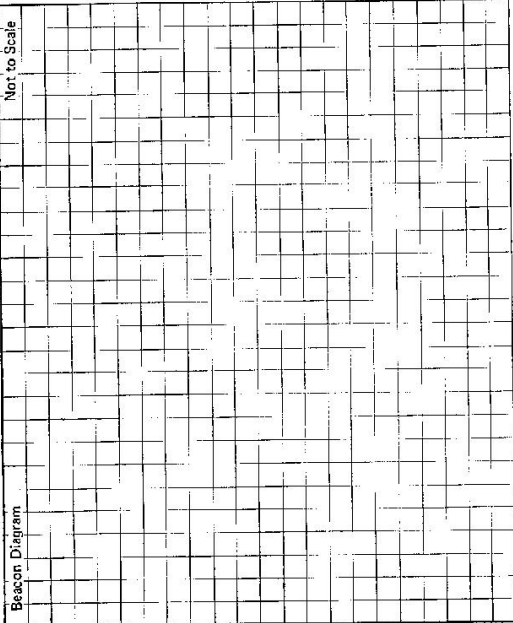

This section to be completed by officer constructing pillar.

Original station mark found/not found.

Description of mark:

Original beacon found/not found.

Description of beacon:

Height Top of Vanes to Top Mark.....m.

Height of mark.....m. above rock/conc.....m. below G.L.

Diameter of Vanes.....m. Height of Cairn.....m.

Original Beacon has/has not been destroyed by me.

STATION

LEE

TS 2828

Owner's Name:

Address:

Phone:

ACCESS

May 1478

Access Report of...../19.....was found suitable/unsuitable.

For access see Bedullock 8727 - N-N

Drive to trig

Mast & vanes destroyed

Rock cairn 1.5m found

360° vision with removal of several scattered trees

Date

Record of Station