


STATION LESTER TS 2837

Owners Name: Current Occupant:

Address:

Dec 1974
 CONVENTIONAL VEHICLE (NB TAKE CARE WITH LOCKS ON TRACK)
 TAKE UELMAN RD FROM LAMINGTON TO HUME PISTOL CLUBS THEN
 OFF ON RIGHT, FOLLOW TRACK AT LEFT OF PISTOL CLUBS. THROUGH
 LOCKED GATE FOR. MILE TO TS.

NB KEY TO LOCKED GATE OBTAINED FROM MR PAT MILLER.
 449 BOWDYS ST
 LAMINGTON.

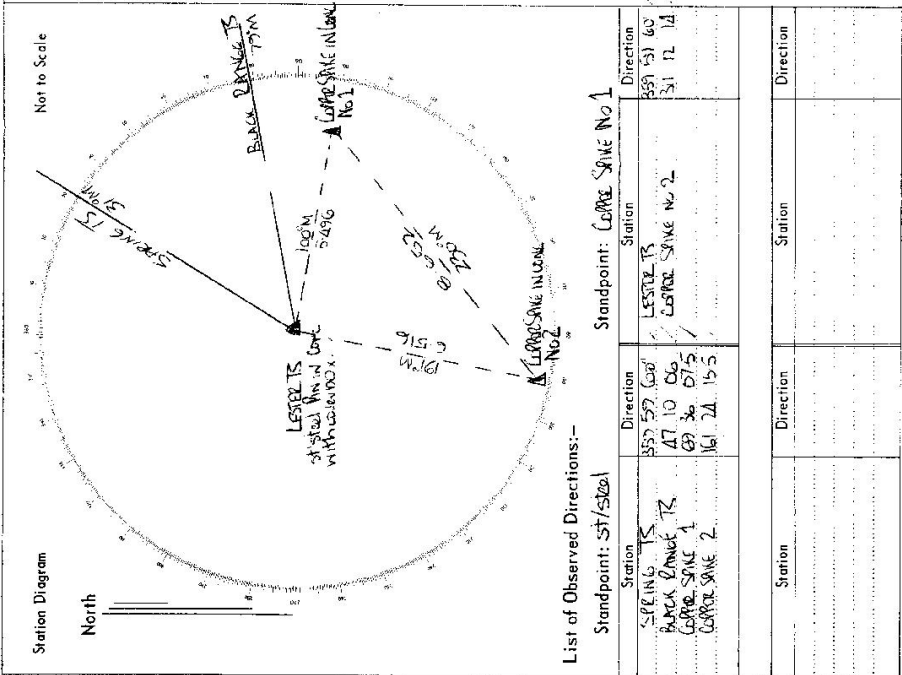

List of Observed Directions:-

Standpoint: ST/SZ22

Standpoint: CORE SPINE NO 1

Station	Direction	Station	Direction
SPEIRING TS	355 59 100	LESTER TS	351 13 60
BLACK SPINE TS	17 10 00	CORE SPINE NO 2	51 12 14
CORE SPINE 1	09 30 075		
CORE SPINE 2	16 12 155		