

CENTRAL MAPPING AUTHORITY  
Department of Lands

Trigonometrical Survey of N.S.W.

RECONNAISSANCE and MAINTENANCE REPORT

STATION LIVINGSTONE TS 2866

This Trig. Station has been:-

Note: Cross out word or words which do not apply

Co: Wynyard | Ph: Livingstone  
Map Sheet: Wagga Wagga | No: 8327  
Inspected by: A. Paterson A.I.S. | Date: 23-11-76  
Authority: Central Mapping Authority | Field Book:  
Beacon Diagram Not to Scale

1. Completely cleared to permit 360° vision to surrounding Trigs. ✓
2. ~~Cleared by James bearing~~ ..... from Trig. Mast
3. Trig. Mast & Vanes ~~have been painted white & black respectively.~~ Vanes ~~gone, mast rotten~~
4. The Trig. was ~~unpiled~~/not unpiled, dimensions now being: .....

Description of mark..... should be explicit, e.g. Steel plug, Brass plug, Bol, G.I. Pipe

Height of mark..... m above rock/concrete ..... m below G.L.

Height of Top Vanes to Top Mark..... m. Diameter of Vanes (vertical) ~~No Vans~~ m.

Height of Cairn 1.1 m. Diameter of Cairn 1.8 m.

Length of Mast 2.8 m. (approximate if not unpiled)

5. A..... set in conc/rock has been placed..... m. bearing..... °M from Trig. Mast
6. A..... set in conc/soil has been placed..... m. bearing..... °M from Trig. Mast
7. A..... set in conc/soil has been placed..... m. bearing..... °M from Trig. Mast
8. A..... set in conc/rock has been placed..... m. bearing..... °M from Trig. Mast

9. Connection..... to..... m. bearing..... °M

10. Connection..... to..... m. bearing..... °M

11. Connection..... to..... m. bearing..... °M

12. Connection..... to..... m. bearing..... °M


13. Diff. Hr. .... is..... m. above below

14. Diff. Hr. .... is..... m. above below

15. Diff. Hr. .... is..... m. above below

16. Diff. Hr. .... is..... m. above below

Note: Suitable for placement of pillar, concrete right to station

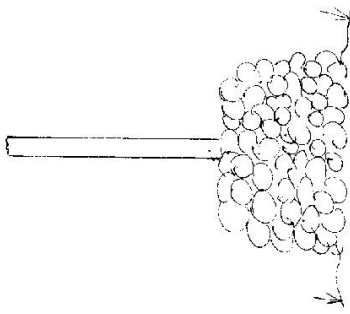

Date	Record of Station

Prepared by: *[Signature]*

Checked: *[Signature]*

Noted on U.T.M. Card

Checked

