

- 15

ARL - 2867

Batch 1636

GEODETIC SURVEY OF A.S.M.

LAND INFORMATION CENTRE

GEODETIC STATION RECONNAISSANCE and MAINTENANCE REPORT

STATION: **ARLINGTON G.S.** No.: **2867**

MAP SHEET SCALE: **1:250 000** **MANARA 1:100 000**

INSPECTED BY: **G. FORD** DATE: **3-8-94**

AUTHORITY: **L.I.C.** FIELD BOOK:

Description: *Note: Cross out word or words which do not apply* **116-3**

1. Cleared by lanes bearing..... **FLAT HILL WITH SMALL LOW BUSH WHICH RESTRICTS FROM Trig. Mast** **202-10**
VISION GOOD FOR G.P.S.
2. Mast & Vanes have been painted white & black respectively.
3. The station/pillar was unpiled/not unpiled/constructed on..... **19**....., dimensions now being:

Description of mark: **S/STEEL PIN**..... should be explicit, e.g., S/Steel ~~Pillar Plate~~, Steel plug, ~~Breast-plate~~, ~~Belt~~, ~~G.T. Pipe~~

Height of mark..... **0.50**.....m. ^{above} ~~reek/concrete~~ Mark is..... **A.T.**.....m. ^{above} ~~G.L.~~

Height of Top Vanes to Top Mark/Pillar-plate **2.130**.....m. Diameter of Vanes (vertical)..... **1.000**.....m.

Height of Cairn..... **1.300**.....m. Diameter of Cairn..... **1.500**.....m. Name Plate found/not found/placed.

Length of Mast..... **2.63**.....m. (approximate if not unpiled)


4. A..... **SSM**..... set in conc/rock has been placed/found, bearing..... **A.3**.....°N. from Mast/Plug/Pillar

5. A..... **ASTRO PILLAR**..... set in conc/rock has been placed/found, bearing..... **109**.....°M from Mast/Plug/Pillar

6. A..... set in conc/rock has been placed/found, bearing.....°N. from Mast/Plug/Pillar

7. A..... set in conc/rock has been placed/found, bearing.....°M. from Mast/Plug/Pillar

8. Action required.....

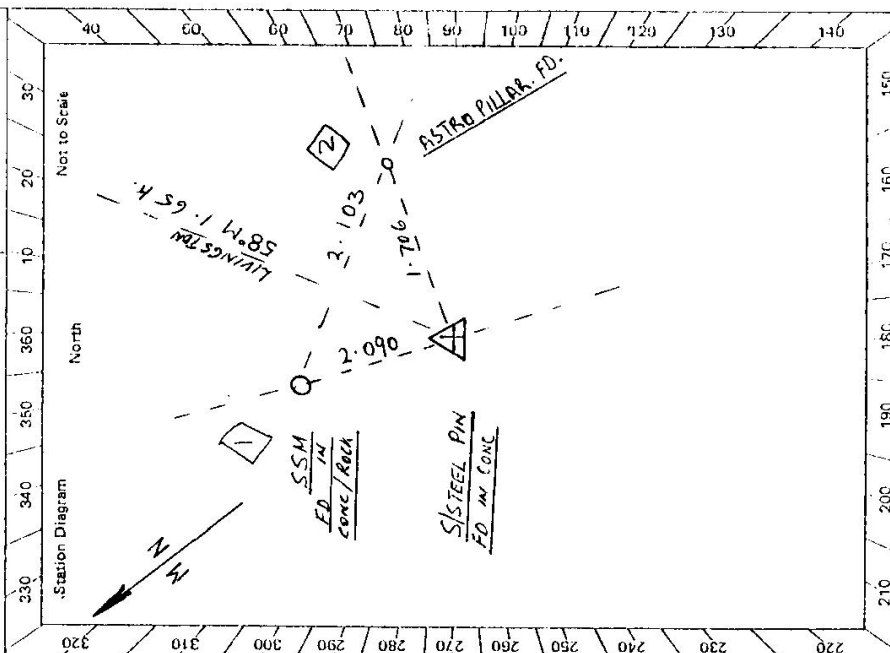

Mark	Direction	Horiz. Distance	Height Difference	Mark	Direction	Horiz. Distance	Height Difference
Livingstone GS	0° 00' 00"	1653.08	above standpt.	Livingstone GS	0° 00' 00"	1651.06	above standpt.
Astro Pillar	50° 57' 08"	1.706	above standpt.	Astro Pillar	116° 41' 59"	2.103	above standpt.
SSM in Conc	344° 41' 26"	2.091	above standpt.	S/S. Pin in Conc	164° 41' 28"	2.090	above standpt.
			below standpt.				below standpt.
			above standpt.				above standpt.
			below standpt.				below standpt.
			above standpt.				above standpt.
			below standpt.				below standpt.

STANDPOINT: **S/S. Pin in Conc.**

Prepared by: **G. Ford 10/8/94** Checked: **M. J. B. 24-8-94** Noted on U.T.M. Card

TS 2867

STATION ARLINGTON G.S

Owner's Name: MR. DICK PALMER Current Occupant:
 Address: MANARA (MANARA PASTORAL CO.) Address:
VIA IVANHOE Phone:

ACCESS

Access Report of/...../19..... was found suitable/unsuitable.

- 0.0 MANARA HOME STEAD [IVANHOE 65M COBB HWY]
- 0.2 HEAD TOWARDS WILCANNIA
- 0.2 AT CREST OF HILL AND WILOMI TURN LEFT
- 0.7 THROUGH DOUBLE IRON GATES
- 0.7 PASS TOWER ON R.H.S.
- 0.8 PASS LIVINGSTONE GS ON R.H.S. AND HEAD SOUTH ALONG RIDGE
- 1.6 CROSS FALLEN DOWN FENCE (KEEP TO R.H.S. SIDE OF RIDGE)
- 1.9 TURN RIGHT DOWN HILL TOWARDS CREEK AND FOLLOW UP ALONG CREEK TO SADDLE AND HEAD OF CREEK
- 2.5 [TRIG UP ON RIDGE ON YOUR RIGHT]
- 2.7 AT HEAD OF CREEK x SADDLE HEAD SOUTH
- 2.7 START VEERING RIGHT UP RIDGE [MAKE OWN WAY]
- 2.9 RIGHT ALONG TOP OF RIDGE
- 3.2 AT TRIG.

Date	Record of Station