

15.02

Department of Lands

Integration Survey of N.S.W.  
**RECONNAISSANCE and MAINTENANCE REPORT**

STATION **LLOYD T.S 2871**

Co: CUMBERLAND Ph: COWAN  
 Map Sheet: COWAN 1 25000 No: S130-IV-N  
 Inspected by: **H.C. BORDER** Date: **2.12.82**  
 Authority: **LANDS S.C.6** Field Book: **1777**

Beacon Diagram Not to Scale

This Trig. Station has been: *Note: Cross out words which do not apply*


1. ~~Completely cleared to permit 360° vision to surrounding trig.~~
2. Cleared by lances bearing **57°**, **95°**, **125°**, **155°**, **170°** from Trig. Mast
3. Trig. Mast & Vanes have been painted white & black respectively. ✓
4. The Trig. was unpiled/~~not unpiled~~ dimensions now being:

Description of mark **BEACON TRIG. PILE** should be explicit, e.g. Steel plug, Brass plug, Bolt, Concrete Pillar  
 Height of mark **0.015** m <sup>above</sup> rock, **concrete** <sub>below</sub> G.L.  
 Height of Top Vanes to Top Mark/Top Pillar plate **3.745** m Diameter of Vanes (vertical) **1.00** m.  
 Height of Cairn **1.1** m. Diameter of Cairn **2.2** m.  
 Length of Mast **3.76** m. (approximate if not unpiled)

5. A **Drill Hole** set in ~~conc/rock~~ **conc/rock** has been placed/fd **5.38** m. bearing **9** °M from Trig. <sup>Plug</sup> Mast/pillar
6. A **Copper Nail** set in ~~conc/soil~~ **conc/soil** has been placed/fd **6.17** m. bearing **251** °M from Trig. <sup>Plug</sup> Mast/pillar
7. A ~~set in conc/soil~~ has been placed/fd ~~.....~~ m. bearing ~~.....~~ °M from Trig. Mast/pillar
8. A ~~set in conc/rock~~ has been placed/fd ~~.....~~ m. bearing ~~.....~~ °M from Trig. Mast/pillar

9. Connection ~~.....~~ to ~~.....~~ m. bearing ~~.....~~ °M
10. Connection ~~.....~~ to ~~.....~~ m. bearing ~~.....~~ °M
11. Connection ~~.....~~ to ~~.....~~ m. bearing ~~.....~~ °M
12. Connection ~~.....~~ to ~~.....~~ m. bearing ~~.....~~ °M
13. Diff. Ht. ~~.....~~ is ~~.....~~ m. <sup>above</sup> ~~below~~
14. Diff. Ht. ~~.....~~ is ~~.....~~ m. <sup>above</sup> ~~below~~
15. Diff. Ht. ~~.....~~ is ~~.....~~ m. <sup>above</sup> ~~below~~
16. Diff. Ht. ~~.....~~ is ~~.....~~ m. <sup>above</sup> ~~below~~

Prepared by: **H.C. BORDER** Checked: *[Signature]*

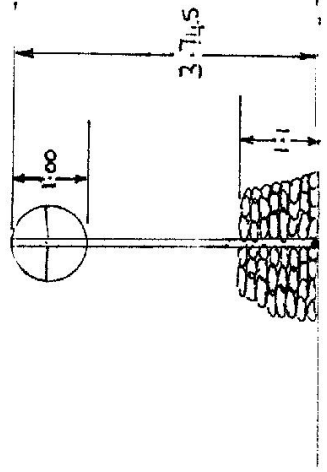

Date	Record of Station
2.12.82	Re-piled Cairn.

