

CENTRAL MAPPING AUTHORITY

GEODETIC SURVEY OF N.S.W.


GEODETIC STATION RECONNAISSANCE and MAINTENANCE REPORT

STATION: **LOBB GS** No.: **2872**

MAP SHEET SCALE 1:250 000 **CANBERRA**

INSPECTED BY: **W MILLER** DATE: **12-1-79**

AUTHORITY: **CMA** FIELD BOOK:

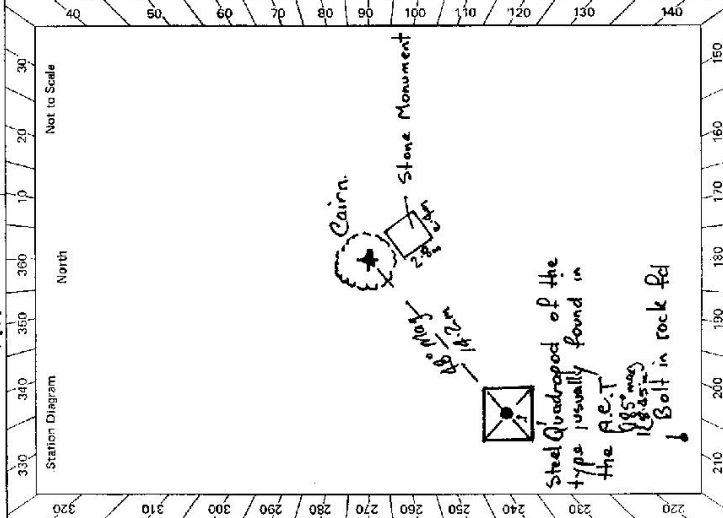

Description:	STANDPOINT:			
	Mark	Direction	Horiz. Distance	Height Difference
1. Cleared by lanes bearing..... 360° <i>Note: Cross out word or words which do not apply from Trig. Mast</i>				
2. Mast & Vanes have been painted white & black respectively.				
3. The station/pillar was unpiled/not unpiled/constructed on..... 19 dimensions now being: Description of mark.....should be explicit, e.g., S/Steel Pillar Plate, Steel plug, Brass plug, Bolt, G.I. Pipe Height of mark.....m. ^{above} rock/concrete; Mark is.....m. ^{above} _{below} G.L. Height of Top Vanes to Top Mark/Pillar platem. Diameter of Vanes (vertical).....m. Height of Cairn..... 2.1mm. Diameter of Cairn..... 2mm. Name Plate found/not found/placed. Length of Mast..... 1m. (approximate if not unpiled)				
4. A.....set in conc/rock has been placed/found, bearing.....°M from Mast/Plug/Pillar				
5. A.....set in conc/rock has been placed/found, bearing.....°M from Mast/Plug/Pillar				
6. A.....set in conc/rock has been placed/found, bearing.....°M from Mast/Plug/Pillar				
7. A.....set in conc/rock has been placed/found, bearing.....°M from Mast/Plug/Pillar				
8. Action required:.....				

Prepared by: **W Miller** 06-1-79. Checked: **Checked**
Noted on U.T.M. Card

STATION LOBB GS TS 2872	Current Occupant: Address: Phone:	At Williamsdale travel about 2.5 km north. Turn right over railway line through gate, - property name "Uralba". Inquire at house. Drive as far as possible toward hill and walk. Drive to access may be possible from the eastern side. - Consult a map. -
Owner's Name: Address: Phone:	ACCESS Access Report of 12/1/1979 was found suitable/unusable.	A Lobb GS.
		Scale approx 1:50 000
Beacon Diagram 		Record of Station Date: 12.1.79 Visited <i>approx</i>
This section to be completed by officer constructing pillar. Original station mark found/not found. Description of mark: Original beacon found/not found. Description of beacon: Height Top of Vanes to Top Mark:m. Height of mark:m. above G.L. below Diameter of Vanesm. Height of Cairnm. Original Beacon has/has not been destroyed by me.		