
	ORT STATION LOCKYER J.J. 1921 MIC 2873	Phi	Map Sheet: $MORISSET$ No: $9131 - N$ Inspected by: $P \int ACKSON$ Date: $19A JOAN 974$				a 25.0 a		2.772 ~	- g/2.0		1.20 *			ATT THE MAN AND THE TANK							Checked
Trigginiumetrical Survey of N.S.W.	RECONNAISSANCE and MAINTENANCE REPORT	Note: Cross out word or words which do not apply	to surrounding Trig s.	from Trig. Mast	ite & black respectively.	sians now being:	Description of mark <i>TR.G., 194, A.M.,R.A.R.</i>	Diamete	Diameter of Cairn	(approximate if not unpiled)	been <i>folded</i> . 2:650.m. bearing	7. Aset in conc/soil has been placedm. bearingbaring	·been placedm. bearingbearing.	.3.2.30. ¹ m. bearing/80 ^a M			m. bearing	m. above	2. m ^V ateve	5 m. above	ahave below	1
CENTRAL MAPPING AUTHORITY	Department of Lands	This Trig. Station has been:-	1 Completely cloared to permit 260° vision to surrounding Trig s.	2. Cleared by lanes bearing	3. Trig. Mast & Vanes have been painted white & black respectively.	4. The Trig. was unpiled/not unpiled, dimensions now being:	Description of mark <i>1.R.GRRR. R. R. R.</i>	Height of Top Vanes to Top Mark, A 468 m.	Height of Cairnm. Dian		 A. M. M. M. M. See in and M. Market has been pl	7. Aset in conc/soil has been p	8. Aset in conc/rock has been pl	9. Connection 70%. R. 16. 61. P. 19. 5. 3.2.34	10. Connectionto	11. Connection	12. Connection to :	13. Diff. Ht. PULAR. PLATE is. 1.115. m. 44000	14. Diff. Ht 224.4.88	15, Diff. Ht	is	Prepared by: & January Checked:

.....

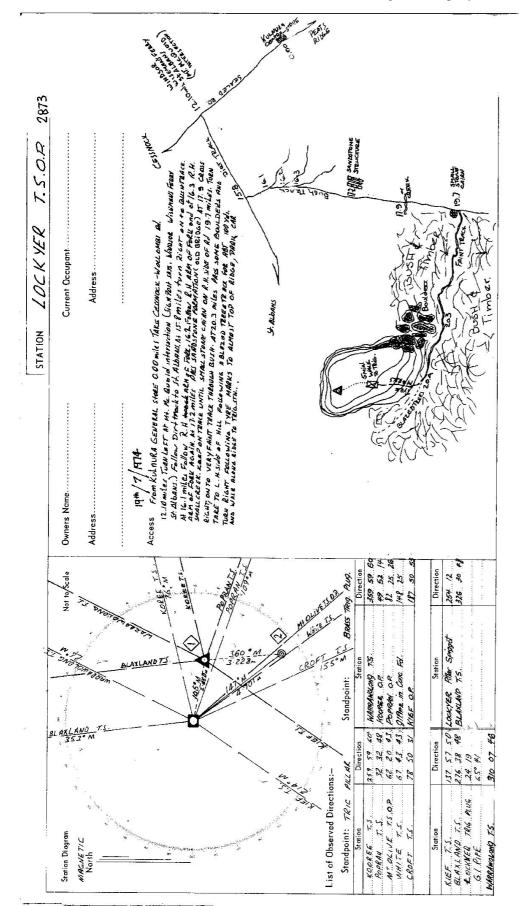


N.S.W. ENANCE REPORT STATION LOCK YER T.S. LPJ 2873	Co: NORTHUM'S ERLAND Ph: LOC	9. Mast Authority L. I. C. Field Book:	Beacon Diagram Not to Scale		olug, Bolt,Concrete Pillar	G.L. 6.1.50		047-0	•M from Trig. Mast/pillar	•M from Trig. Mast/pillar	°M from Trig. Mast/pillar	°M from Trig. Mast/pillar				JUZYS Malked Mast respected.			
Integra Survey of N.S.W. Department of Lands RECONNAISSANCE and MAINTENANCE	This Trig. Station has been:-	Completely cleared to permit 360° vision to surrounding Trige. Kegrewth wards to be cleared Cleared by lanes bearingfrom Trig. Mast	Trig. Mast & Vanes have been painted white & black respectively.	The Trig. was unpiled/not unpiled, dimensions now being:	Description of mark	Height of mark	Height of Cairnm. Diameter of Cairnm.	Length of Mastm. (approximate if not unpiled)	Abearing	Aset in conc/soil has been placed/fdm. bearingM from Tr	Aset in conc/soil has been placed/fdm. bearingw	Aset in conc/rock has been placed/fdm. bearing	Соплестіолtoto ; ; bearing	Connectiontoto	Connection	Connection	Diff. Htisis	Diff. Ht is	 Prepared by: J Correct, Checked:

. management and the second second

•

1000

.

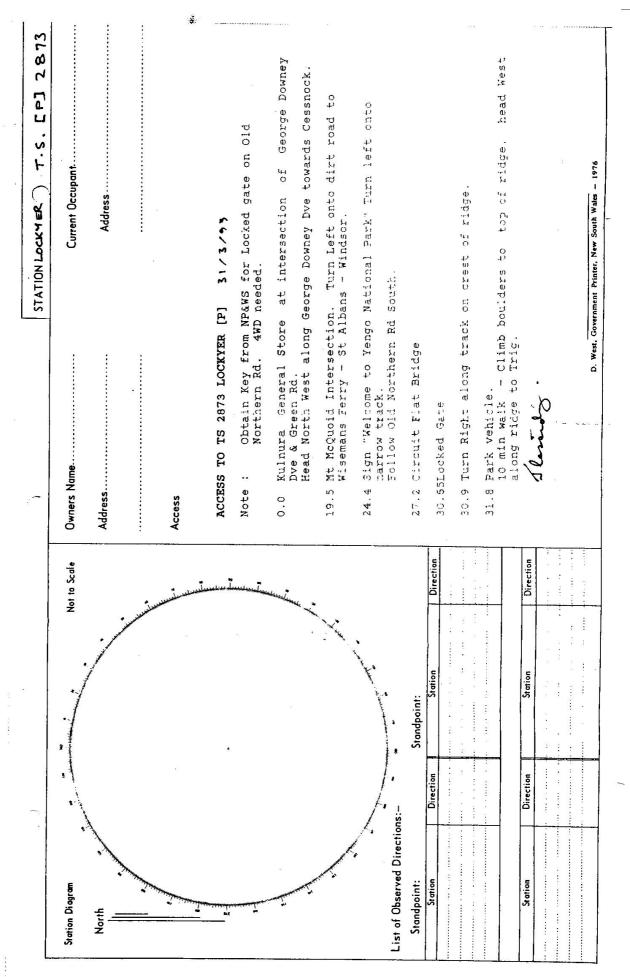

TS2873 | Print Date: 31/05/2022 16:05 | No Of Pages: 4 | Property of DFSI - Spatial Services