

74-98

Trigonometrical Survey of N.S.W.

Department of Lands

RECONNAISSANCE and MAINTENANCE REPORT

STATION LONG REEF TS 2888

This Trig. Station has been:-

Note: Cross out word or words which do not apply

- 1. Completely cleared to permit 360° vision to surrounding Trigs. ✓
- 2. ~~Cleaned by lances-bearing~~ from Trig-Mast

- 3. ~~Trig-Mast & Vanes have been painted white & black respectively.~~
- 4. ~~The Trig. was unspited/not unspited, dimensions now being:~~

Description of mark... ~~Plate~~ should be explicit, e.g. Steel plug, Brass plug, Bolt, G.I. Pipe

Height of mark... ^{1.295} m above rock/concrete m above G.L.

Height of Top Vanes to Top Mark... ^{missing} m Diameter of Vanes (vertical) m.

Height of Cairn... m. Diameter of Cairn m.

Length of Mast... m. (approximate if not unspiled)

- 5. ~~A ^{found} set in conc/rock has been placed~~ m. bearing °M from Trig. Mast
- 6. ~~A ^{found} set in conc/rock has been placed~~ 3.510 m. bearing 305 °M from Trig. Mast
- 7. ~~A ^{found} set in conc/rock has been placed~~ 3.015 m. bearing 241 °M from Trig. Mast
- 8. A set in conc/rock has been placed m. bearing °M from Trig. Mast

- 9. Connection.....to..... m. bearing.....°M
- 10. Connection.....to..... m. bearing.....°M
- 11. Connection.....to..... m. bearing.....°M
- 12. Connection.....to..... m. bearing.....°M

- 13. Diff. Ht. is..... m. ^{above} _{below}
- 14. Diff. Ht. is..... m. ^{above} _{below}
- 15. Diff. Ht. is..... m. ^{above} _{below}
- 16. Diff. Ht. is..... m. ^{above} _{below}

Prepared by:

Checked:

Noted on U.T.M. Card

Checked

Date	Record of Station

Co: Cumberland Ph: Manly Cove
 Map Sheet: Sydney No: 980
 Inspected by: S MOORE Date: 28-6-75
 Authority: C.M.A. Field Book:

Beacon Diagram Not to Scale

7498

CENTRAL MAPPING AUTHORITY
 Department of Lands
 Trigonometrical Survey of N.S.W.
 RECONNAISSANCE and MAINTENANCE REPORT

STATION LONG REEF G.S. (PILLAR) 2888
 Co: CUMBERLAND
 Ph: MANLY COVE
 Map Sheet: SYDNEY
 No: 9130
 Inspected by: W. MCGILLIVRAY
 Date: 5/8/75
 Authority CENTRAL MAPPING
 Field Book:


This Trig. Station has been:-
 Note: Cross out word or words which do not apply

1. Completely cleared to permit 360° vision to surrounding Trigs.
2. Cleared by lanes bearing..... from Trig. Mast
3. Trig. Mast & Vanes have been painted white & black respectively.
4. The Trig. was unpiled/not unpiled, dimensions now being:
 Description of mark..... 5/5 PILLAR PLATE..... should be explicit, e.g. Steel plug, Brass plug, Bal, G.I. Pipe
 Height of mark..... 1.296 m above rock/concrete below G.L.
 Height of Top Vanes to Top Mark..... 1.450 m. Diameter of Vanes (vertical) 0.757 m.

5. A..... set in conc/rock has been placed..... m. bearing.....°M from Trig. Mast
6. A..... set in conc/soil has been placed..... m. bearing.....°M from Trig. Mast
7. A..... set in conc/soil has been placed..... m. bearing.....°M from Trig. Mast
8. A..... set in conc/rock has been placed..... m. bearing.....°M from Trig. Mast
9. Connection..... to..... : m. bearing.....°M
10. Connection..... to..... : m. bearing.....°M
11. Connection..... to..... : m. bearing.....°M
12. Connection..... to..... : m. bearing.....°M
13. Diff. Ht. is..... m. above below
14. Diff. Ht. is..... m. above below
15. Diff. Ht. is..... m. above below
16. Diff. Ht. is..... m. above below

Prepared by: *Bob Smith 11/1/76* Checked: *Paul May 11/1/76*. Noted on U.T.M. Card

Beacon Diagram Not to Scale

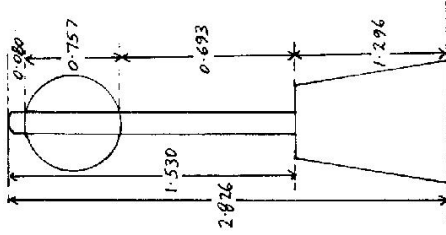

Date Record of Station
 5-8-75 NEW MAST & VANES ERECTED

Checked