

CENTRAL MAPPING AUTHORITY
Department of Lands

Trigonometrical Survey of N.S.W.

RECONNAISSANCE and MAINTENANCE REPORT

This Trig. Station has been:-

Note: Cross out word or words which do not apply

1. Completely cleared to permit 360° vision to surrounding Trigs.
2. Cleaned by lances bearing from Trig. Mast
3. Trig. Mast & Vanes have been painted white & black respectively. Original Station Mark found/not found
4. The Trig. was unpiled/not unpiled, dimensions now being: should be explicit, e.g. Steel plug, Brass plug, Bolt, G.I. Pipe

Description of mark.....
 Height of mark..... m ^{above} / _{below} rock/concrete m ^{above} / _{below} G.L.
 Height of Top Vanes to Top Mark..... m. Diameter of Vanes (vertical)..... m.
 Height of Cairn..... m. Diameter of Cairn..... m.

- Length of Mast..... m. (approximate if not unpiled)
5. A..... set in conc./rock has been placed..... m. bearing.....°M from Trig. Mast
 6. A..... set in conc./soil has been placed..... m. bearing.....°M from Trig. Mast
 7. A..... set in conc./soil has been placed..... m. bearing.....°M from Trig. Mast
 8. A..... set in conc./rock has been placed..... m. bearing.....°M from Trig. Mast


9. Connection..... to..... m. bearing.....°M
10. Connection..... to..... m. bearing.....°M
11. Connection..... to..... m. bearing.....°M
12. Connection..... to..... m. bearing.....°M
13. Diff. Ht. is..... m. ^{above} / _{below}
14. Diff. Ht. is..... m. ^{above} / _{below}
15. Diff. Ht. is..... m. ^{above} / _{below}
16. Diff. Ht. is..... m. ^{above} / _{below}

Prepared by: J. Sherwin ATS 21477 Checked: _____

Noted on U.T.M. Card

STATION LOOMBAH T. S. 2892
 Co: GORDON | Ph: BURGAWONG
 Map Sheet: CUMNOCK 1:50000 | No: 8632-S
 Inspected by: J. SHERWIN | Date: 24/3/77
 Authority: CMA | Field Book: _____

Beacon Diagram Not to Scale

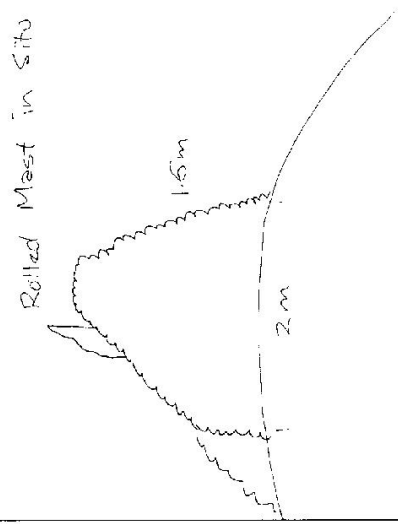

Date	Record of Station

Checked

